


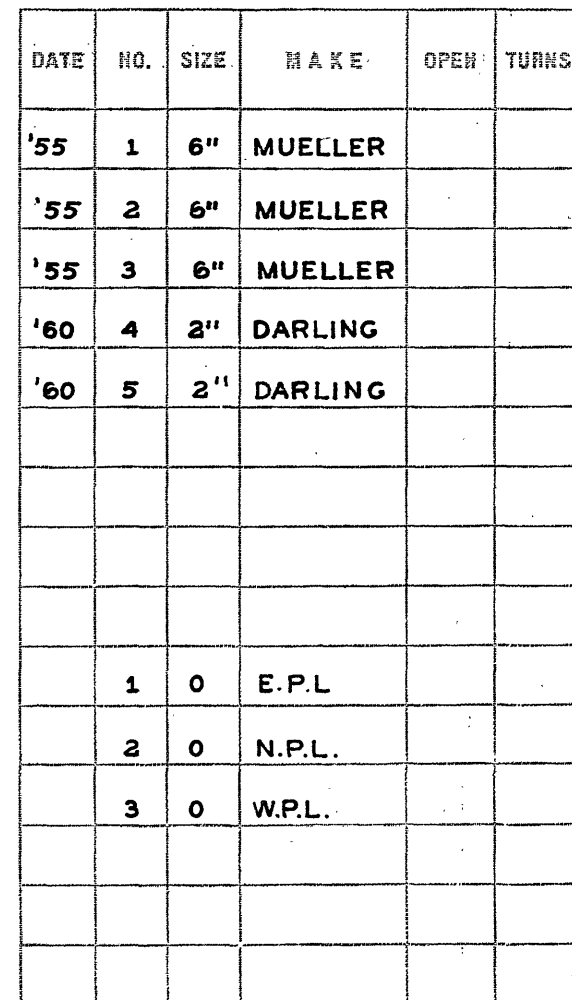

REF ID:

9/2000 JH