


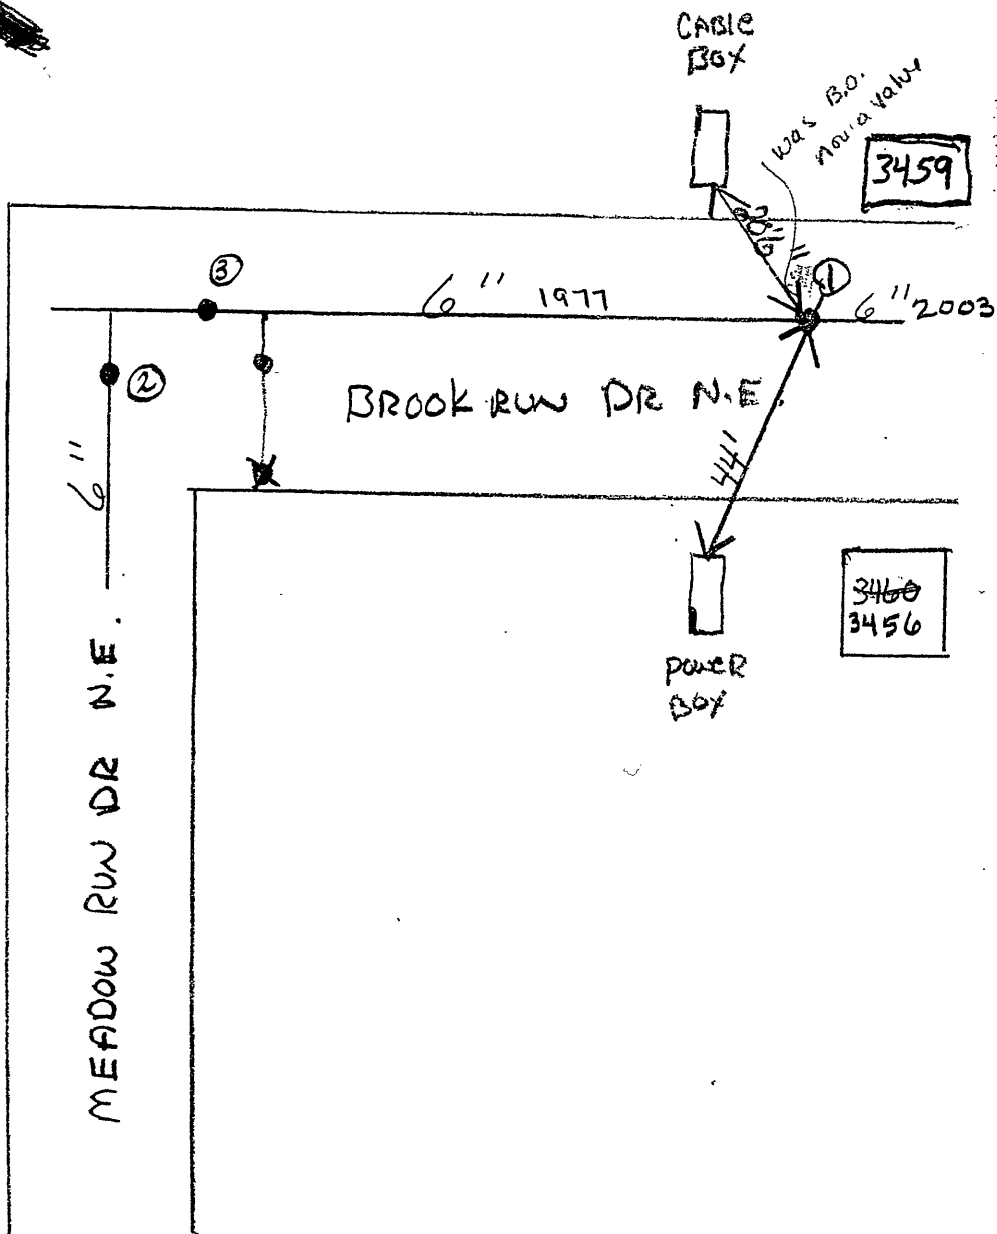

DATE	NO.	SIZE	MAKE	OPEN	TURNS
9-2-03	1	6"	ANK	R	21
5/12/1977	1	6"	Blow off		
5/12/1977	2	6"			
5/12/1977	3	6"			

P. L. Measurements		
No.	Distance	Direction

CITY OF ROANOKE - WATER DEPT.
 VALVE DIAGRAM
~~DEAD END OF~~
~~BROOK RUN DR NE~~

Sec. Map 710 OAD# 0673
 Date 9-2-03 Page No.