


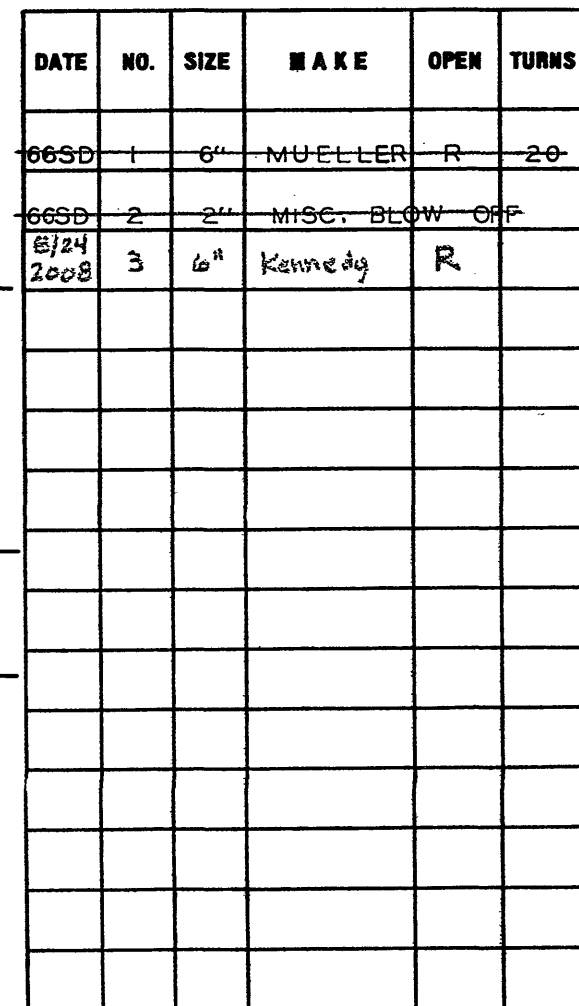

**BROOKVIEW ROAD &
CLEARWATER AVENUE N.E.**

SEC. MAP 58 Roanoke County

DATE PAGE NO.