


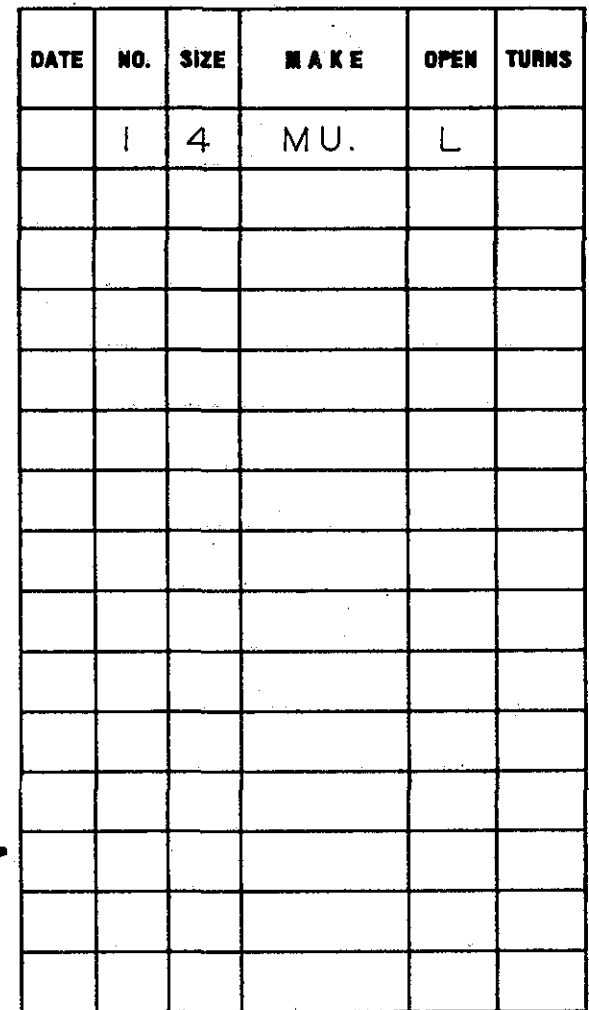

CITY OF ROANOKE—WATER DEPT.	
VALVE DIAGRAM	
BROOKVIEW RD. &	
RIDGECREST DR. N.E.	
SEC. MAP	58 Roanoke County
DATE	9 - 7 - 66
PAGE NO.	