


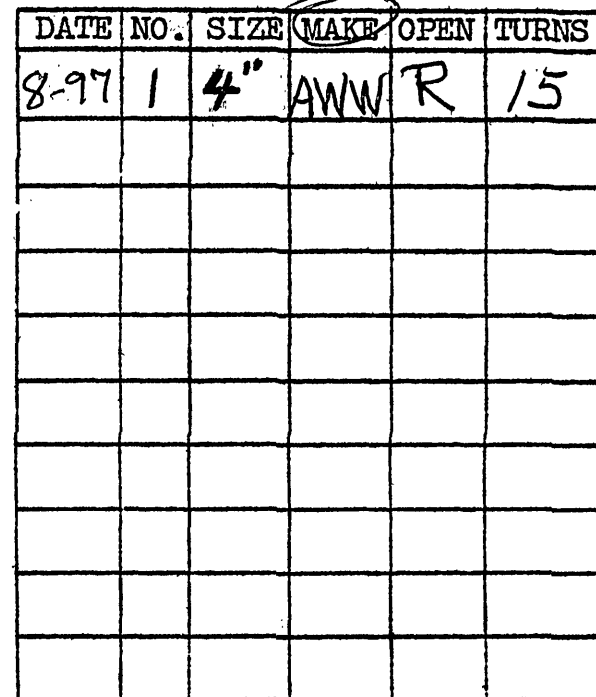

CITY OF ROANOKE - WATER DEPT.
VALVE DIAGRAM
Cannaday Rd.
Mecca Street
West Intersection
Sec. Map 707 NE
Date Page No.