


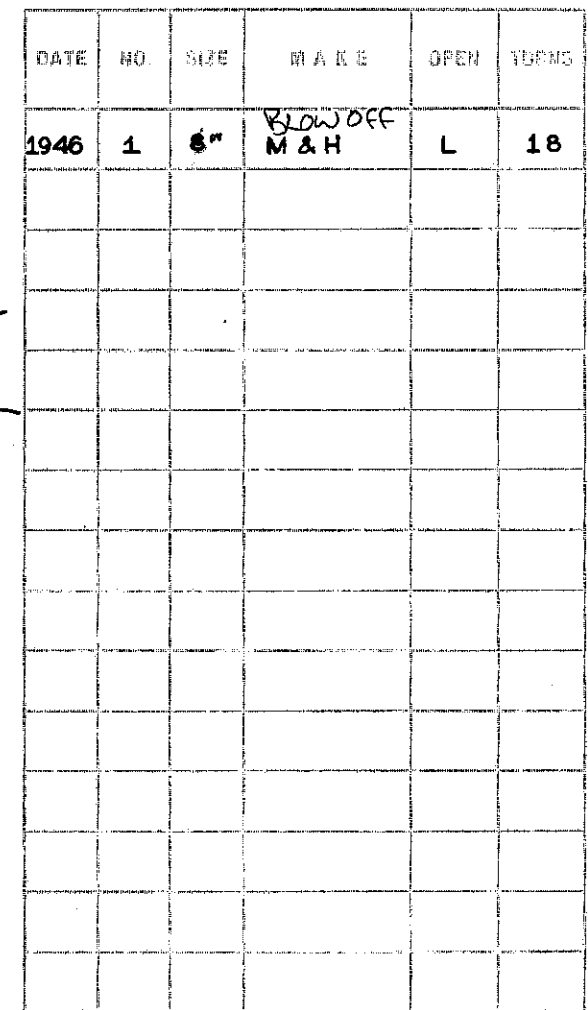

PAGE NO. NE 139