


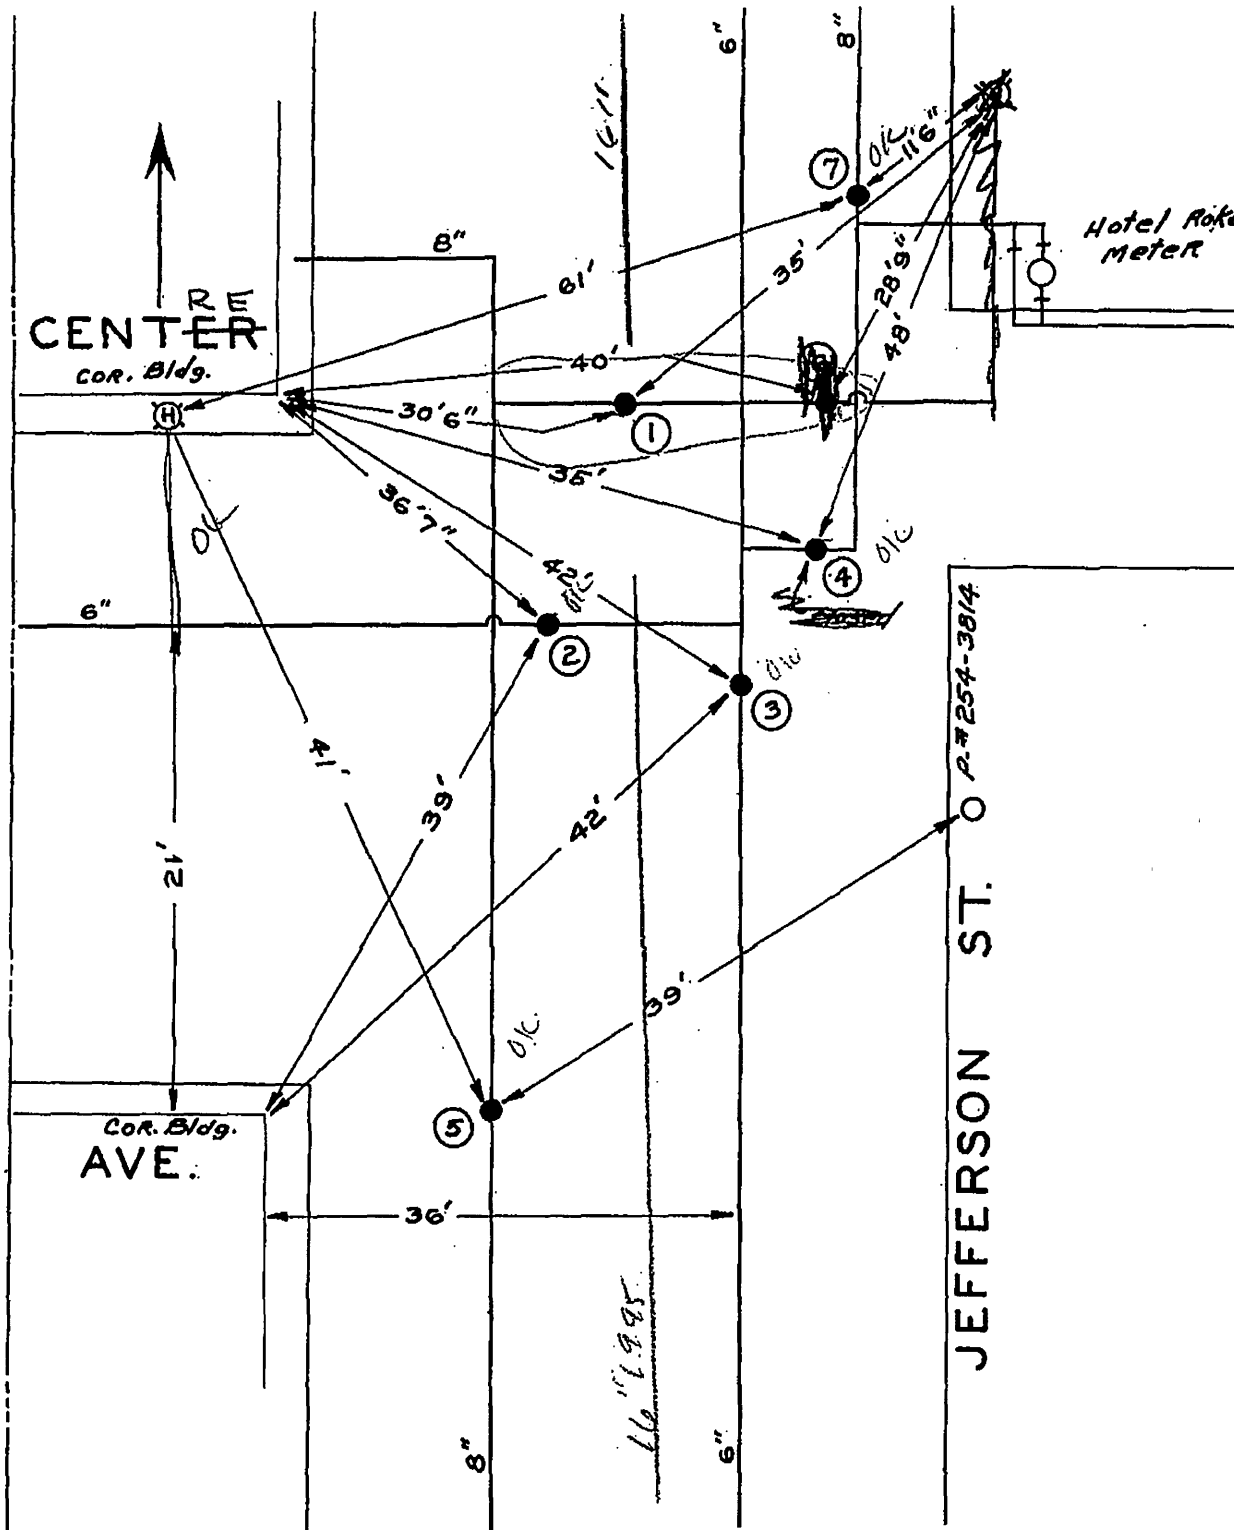

DATE	NO.	SIZE	MAKE	OPEN	TURNS
'24	1	6"		L	14
'22	2	6"		R	20½
'89	3	6"		R	20
'47	4	6"	DARLING	R	27
'59	5	8"	MUELLER	R	
	6	6"	F.H. VALVE		
'59	7	8"	DARLING	R	
	1	12"-N	NPL		
	2	28"-E	WPL		
	3	21"-N	SPL		
	4	6"-S	NPL		
	5	0	SPL		
	6	12"-N	NPL		
	7	17"-N	NPL		

Still closed valve? no

4/89

CITY OF ROANOKE—WATER DEPT	
VALVE DIAGRAM	
CENTER ^{RE} AVENUE &	
JEFFERSON ST. N.W. OR	
N E	
SEC. MAP	201-301
DATE	PAGE NO