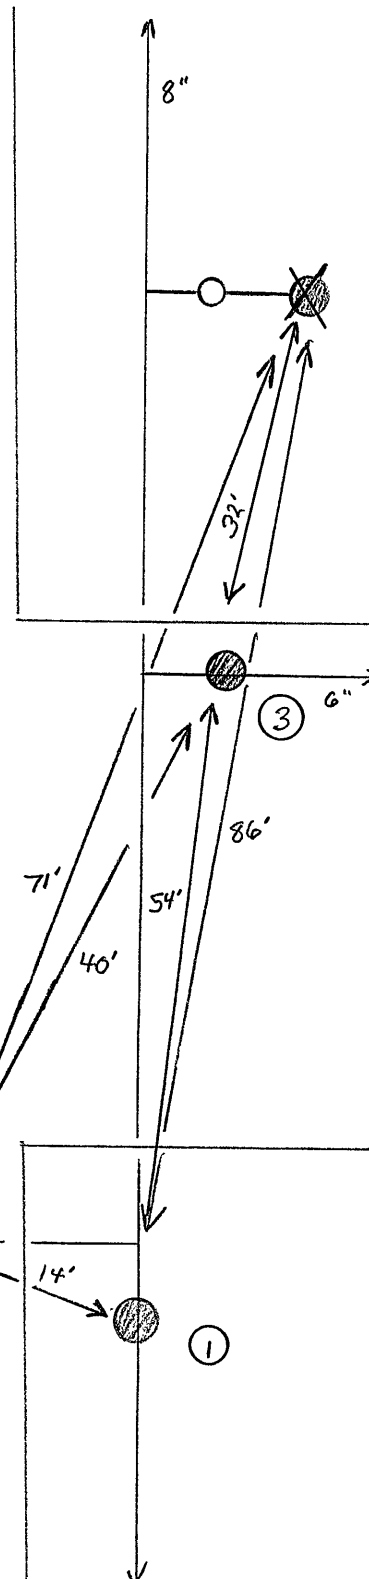
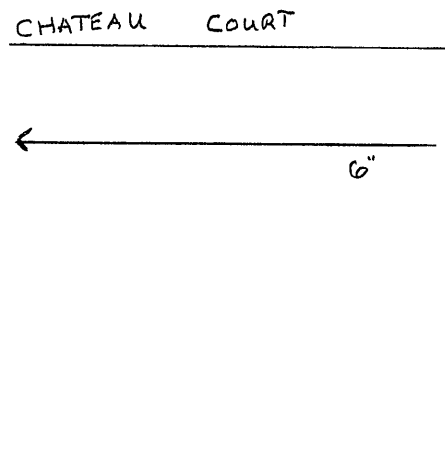


[illegible]

WESTERN VIRGINIA WATER AUTHORITY
VALVE DIAGRAM
CHATEAU COURT AND GOLDEN Ivy Dr.
SECT. MAP County
DATE 8-18-04