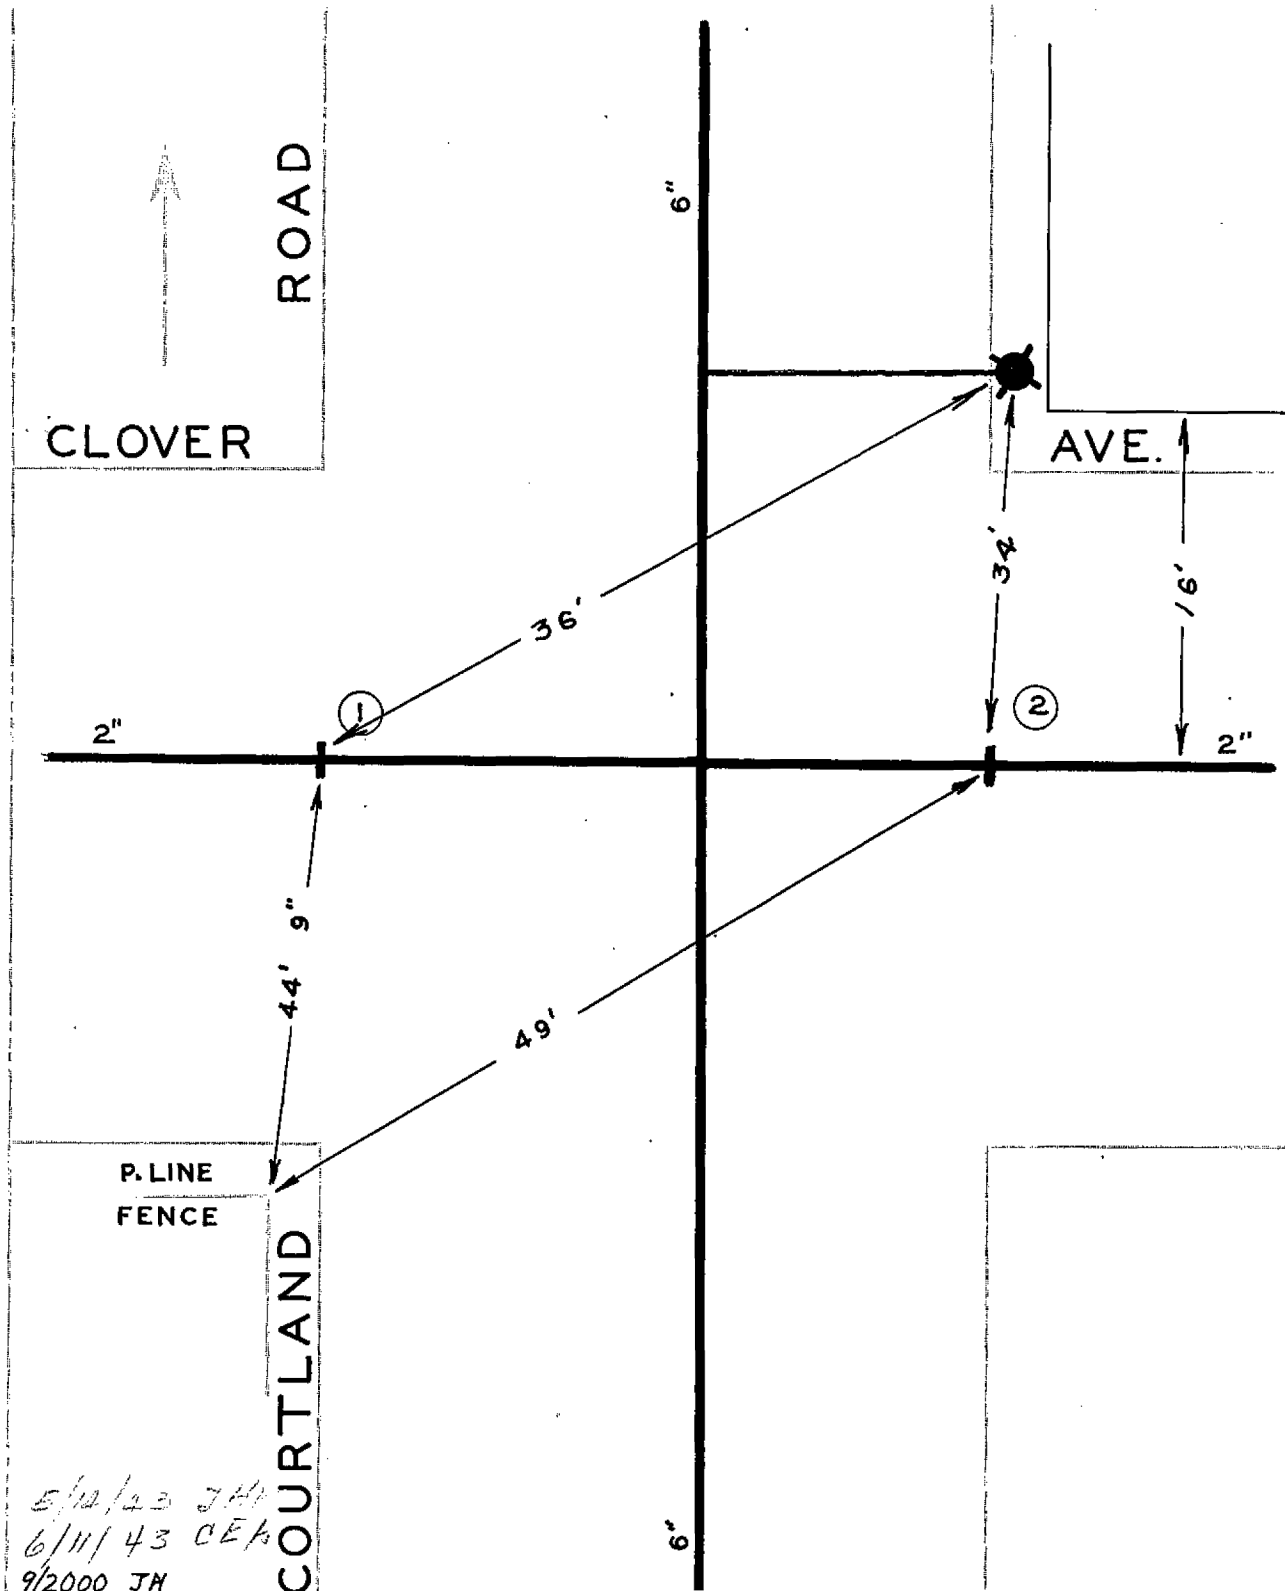


[illegible]

CITY OF ROANOKE - WATER DEPT
VALVE DIAGRAM
CLOVER AVE. &
COURTLAND ROAD
VOL. MAP 308 N.W.
DATE PAGE NO. 1