


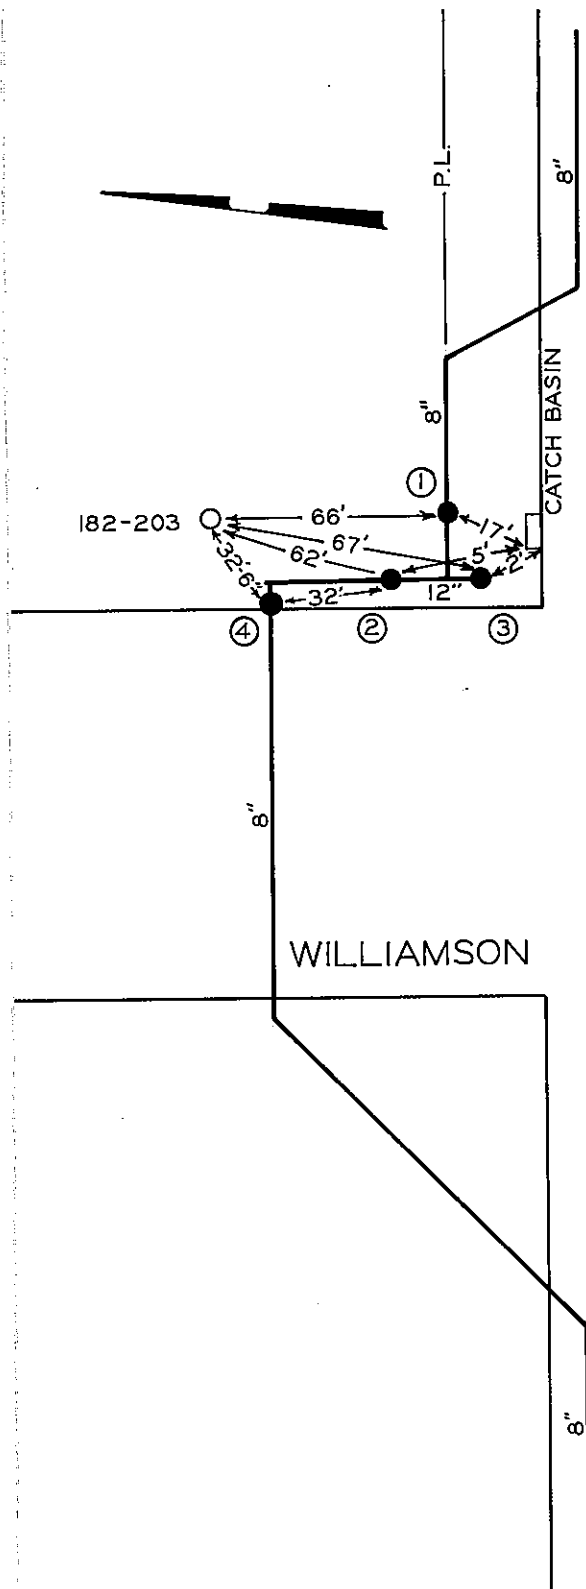

CLUBHOUSE DRIVE

ROAD

DENT ROAD

[illegible]

CLUBHOUSE DRIVE &
WILLIAMSON ROAD N.E.

WILLIAMSON ROAD N.E.

1,2 Roanoke County

1997, 1998, 1999, 2678, 26