


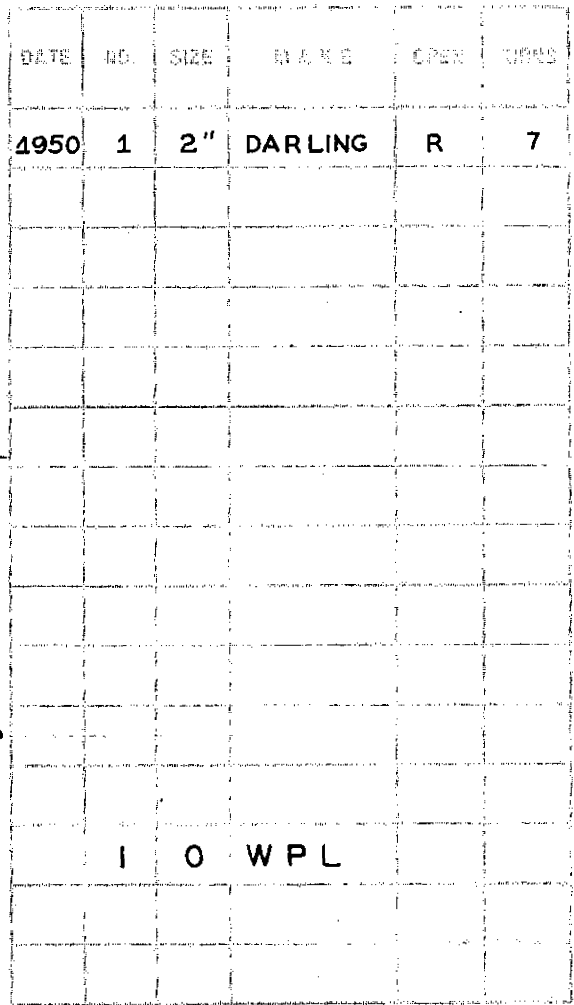

307
DATE 3/4/50 PAGE NO N.E.151

9/2000 JH