


$\frac{d}{dt} \left(\frac{\partial L}{\partial \dot{x}} \right) = \frac{\partial L}{\partial x}$

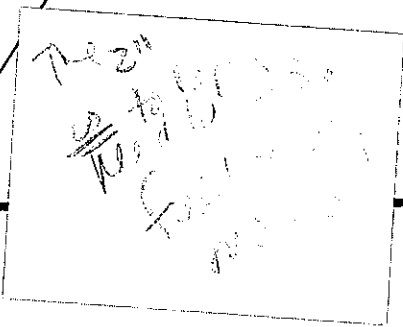

CITY OF ROANOKE — WATER DEPT
VALVE DIAGRAM
COMPTON STREET &
WILLIAM SON RD. N.E.
SEP MAP 307
DATE 4/9/47 PAGE NO NE102