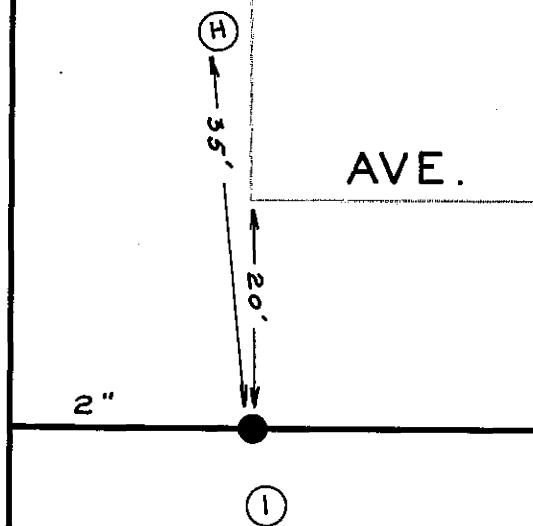


80

[illegible]

CITY OF ROANOKE — WATER DEPT	
VALVE DIAGRAM	
CONNECTICUT	AVE. &
6TH. ST. N. E.	
SEC. MAP	304
DATE	PAGE NO