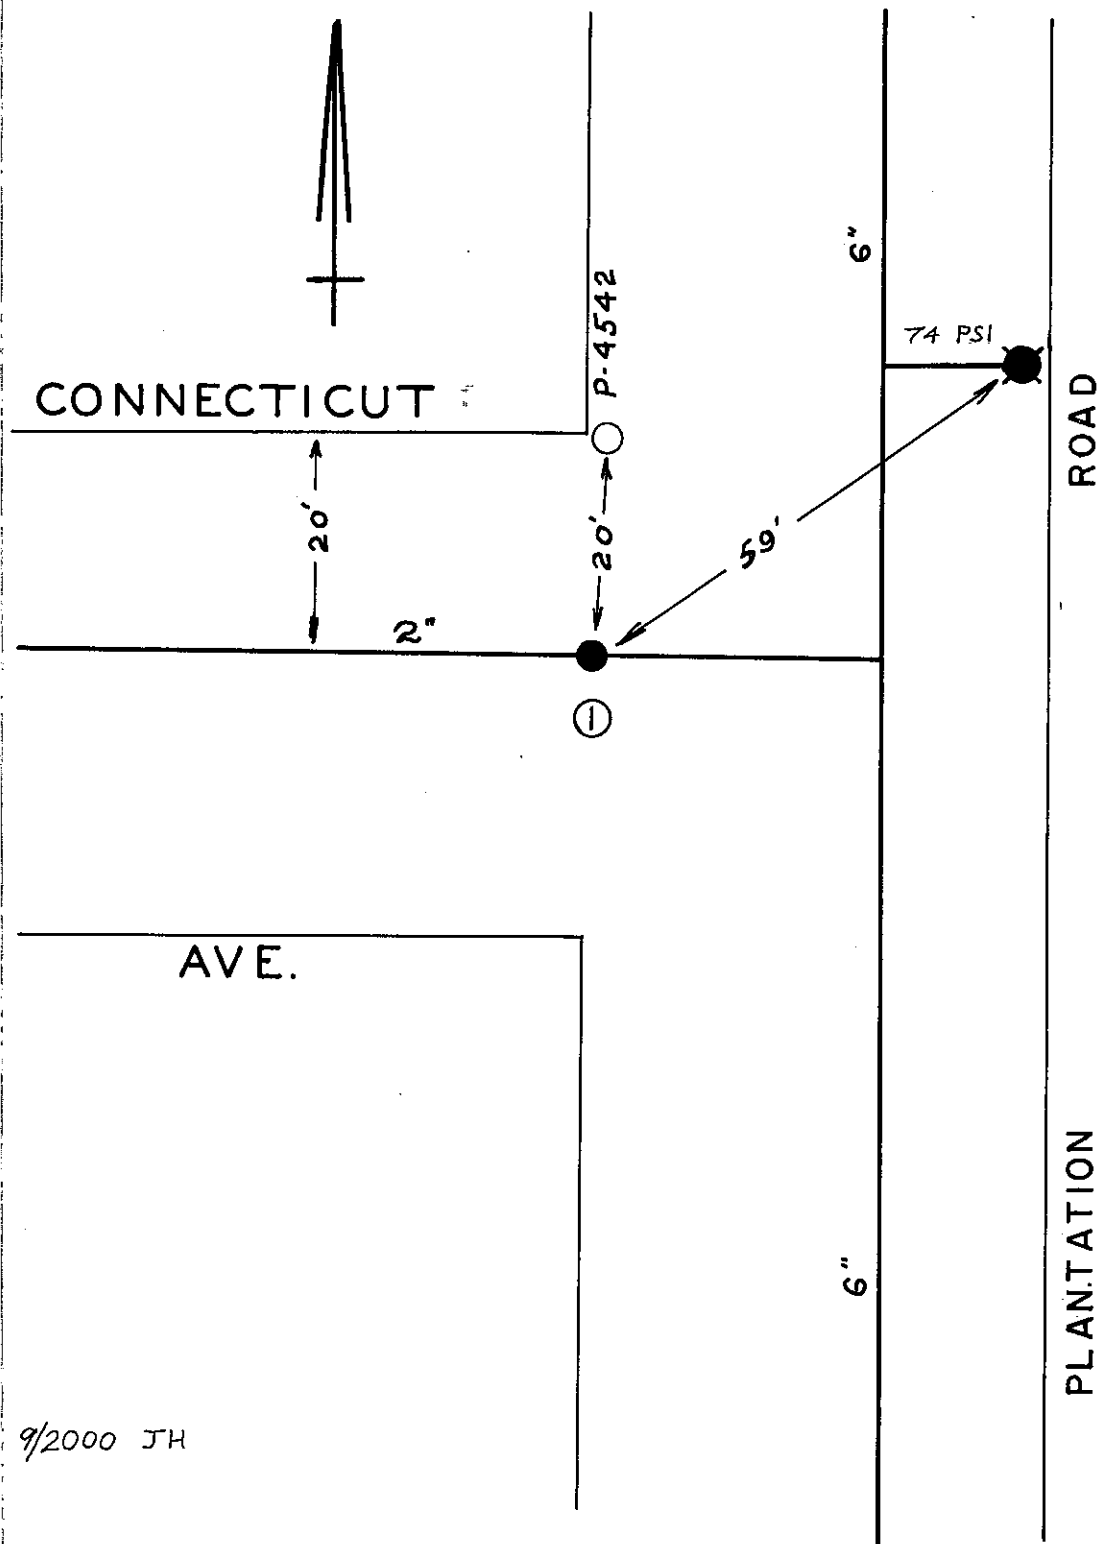


[illegible]

CITY OF ROANOKE—WATER DEPT.	
VALVE DIAGRAM	
CONNECTICUT AVENUE &	
PLANTATION ROAD	
SEC. MAP	304
DATE	PAGE NO. N.E.