


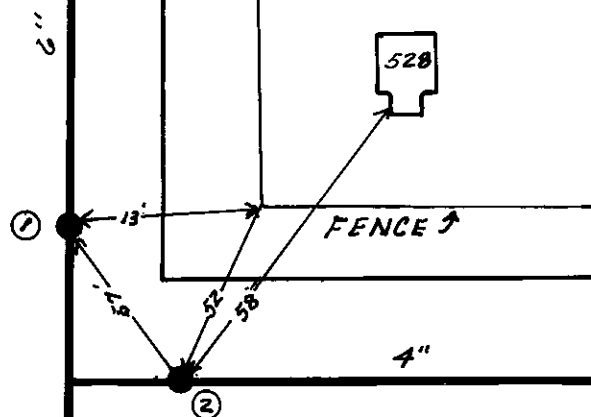

LONG ACRE DRIVE

[illegible]

ELMCREST DRIVE AND
LONG ACRE DRIVE

SEC. MAP 739

N.E.

DATE **JULY 11, 1980** PAGE NO.