


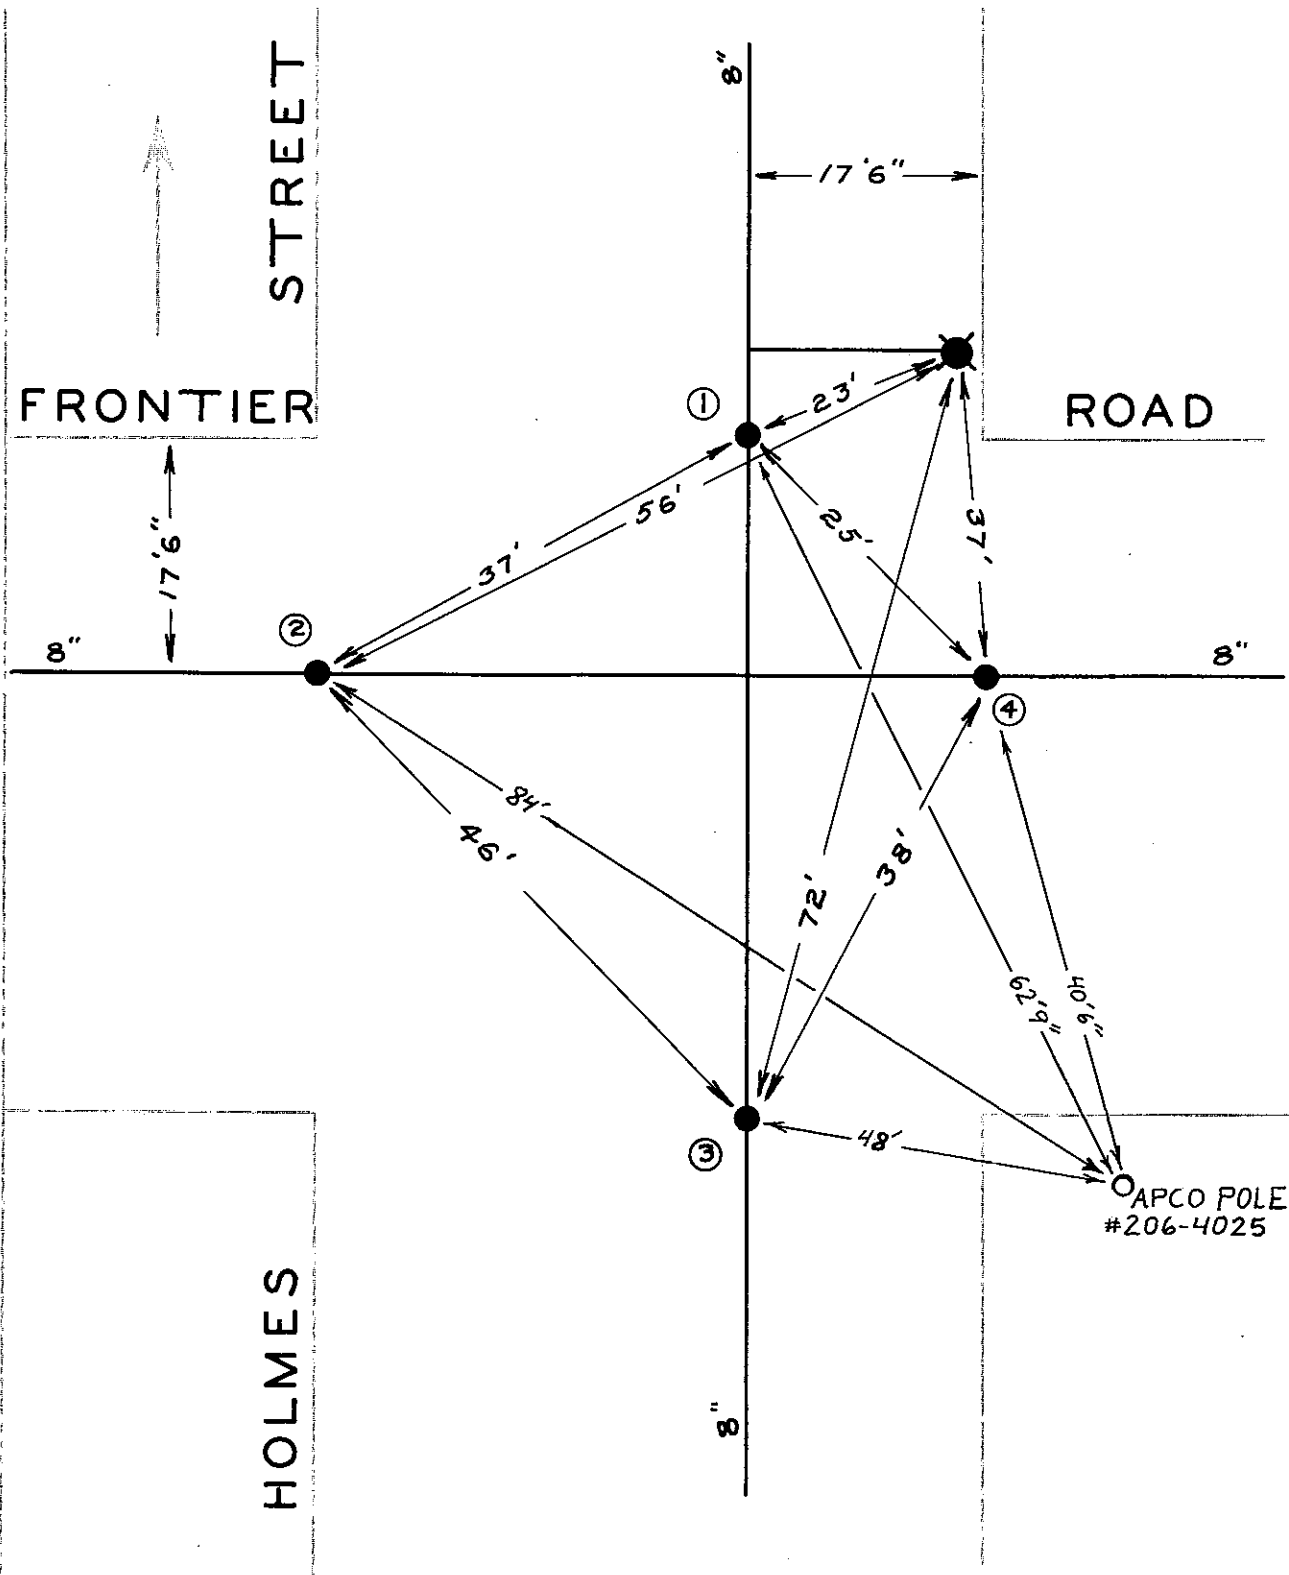

DATE	NUM.	SIZE	NAME	OPEN	WURLS
3-57	1	8"	DARLING	R	
4-57	2	8"	DARLING	R	
3-57	3	8"	DARLING	R	
4-57	4	8"	DARLING	R	
	1	0	NPL		
	2	0	WPL		
	3	0	SPL		
	4	0	EPL		

CITY OF HOARONE--WATER DEPT
VALVE DIAGRAM
FRONTIER RD. &
HOLMES ST. N.E.
SEP 23 1939
OLIVE PAGE NO