


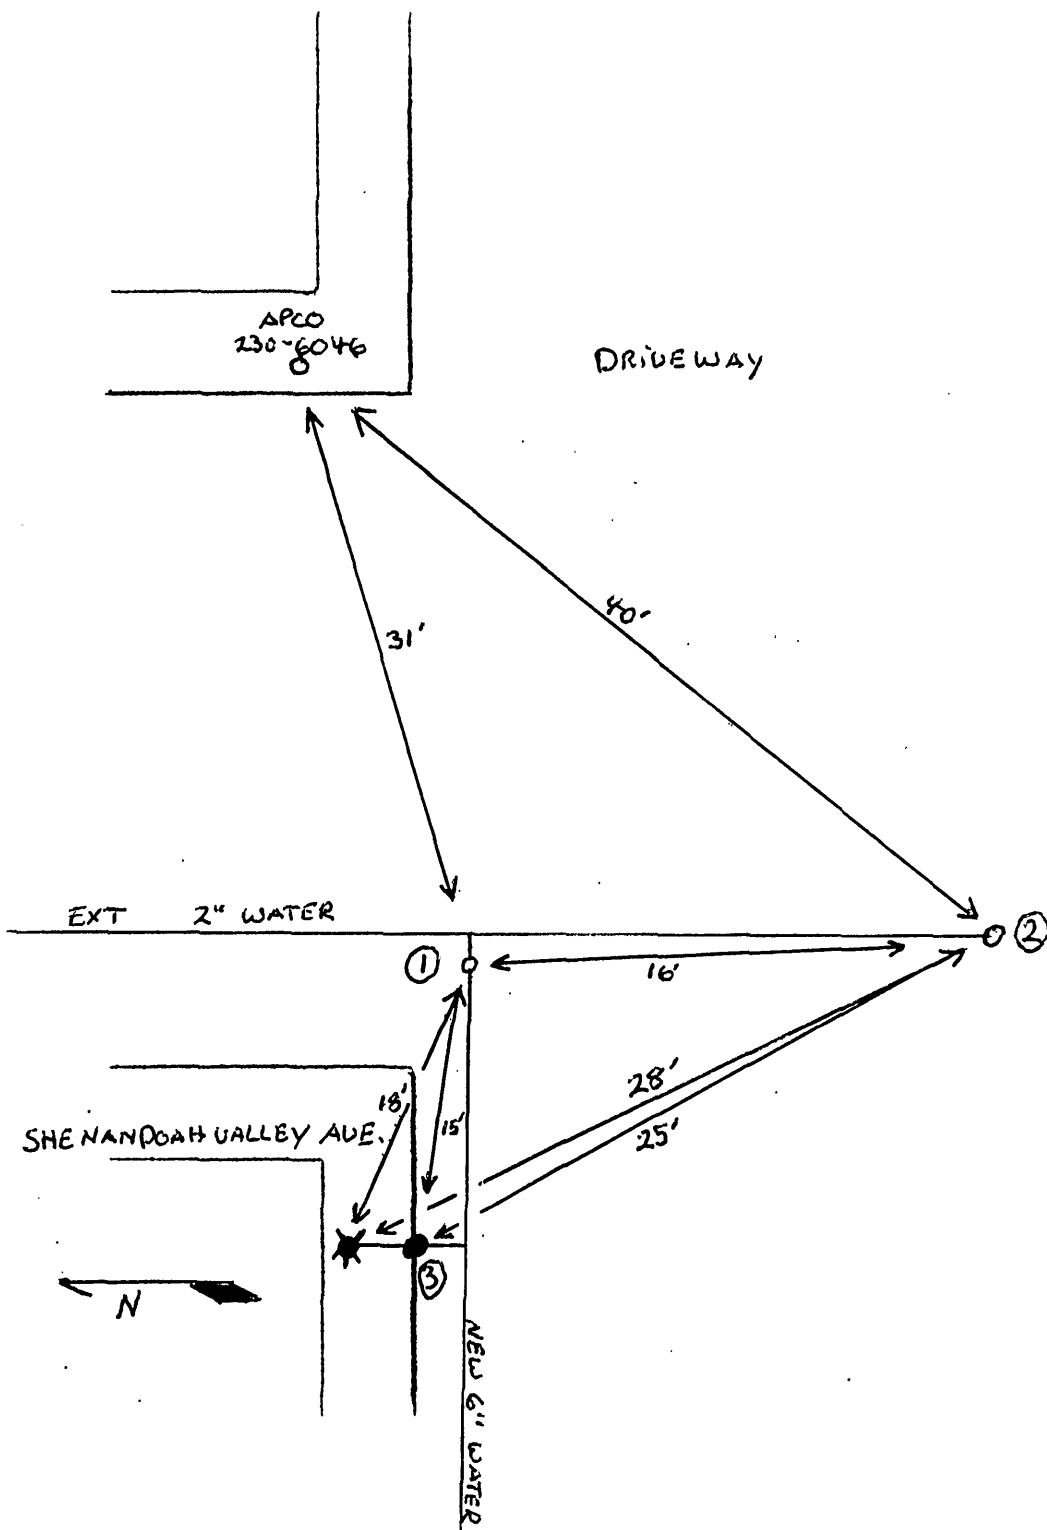

DATE	NO.	SIZE	MAKE	OPEN	TURNS
1-99	1	2"	MISC	L	8½
	2	2"	MISC	L	8½
1-99	3	6"	DARLING	R	21

P. L. Measurements		
No.	Distance	Direction

CITY OF ROANOKE - WATER DEPT.	
VALVE DIAGRAM	
SHENANDOAH VALLEY AVE AND	
FUGATE ROAD NE.	
Sec. Map 315	
Date 1-99	Page No.

FUGATE ROAD NE