


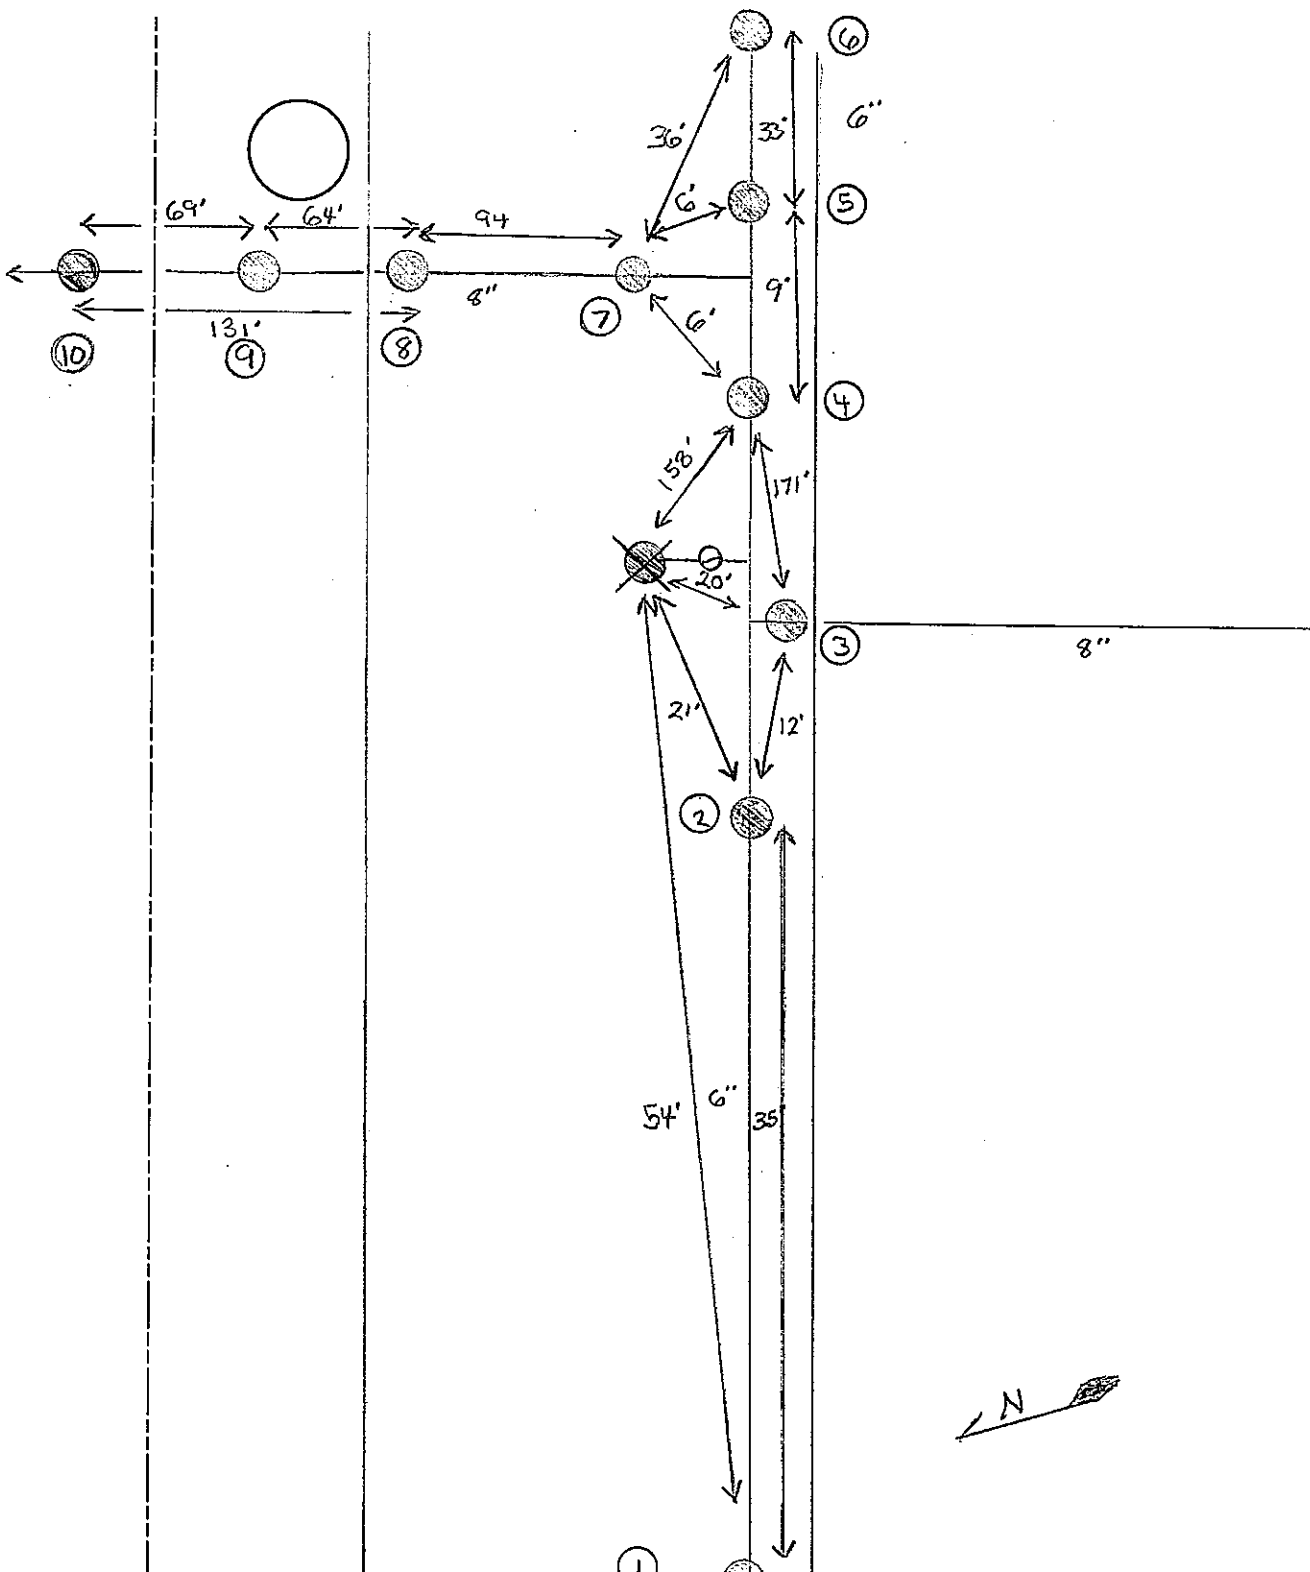

DATE	NO.	SIZE	MAKE	OPEN	TURNS
2004	1	6"	BLOW OFF		
2004	2	6"	AMERICAN	L	21
2004	3	8"	AMERICAN	L	27
2004	4	8"	AMERICAN	L	27
2004	5	6"	AMERICAN	L	21
2004	6	6"	BLOW OFF		
2004	7	8"	AMERICAN	L	27
2004	8	8"	AMERICAN	L	27
2004	9	8"	IN LINE BLOW OFF		
2004	10	8"	AMERICAN	L	27

GOLDEN IUY

WINDRUSH

WESTERN VIRGINIA WATER AUTHORITY
VALVE DIAGRAM
GOLDEN IUY AND WINDRUSH
SECT. MAP COUNTY
DATE 8-19-04