




8"
4784 APCO POLE #206-5501

4778

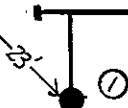

6"

8"

8"

GOLFVIEW DRIVE

DATE	NO.	SIZE	MAKE	OPEN	TURNS
	1	6"		R	

CITY OF ROANOKE—WATER DEPT VALVE DIAGRAM
GOLFVIEW DRIVE
N.E.
SEC. MAP 739,740.
DATE JULY 11, 1980 PAGE NO.