


3022

DATE	NO.	SIZE	TYPE	REMARKS
7-76	1	8"	R	27
7-76	2	8"	R	27
7-76	3	8"	R	27

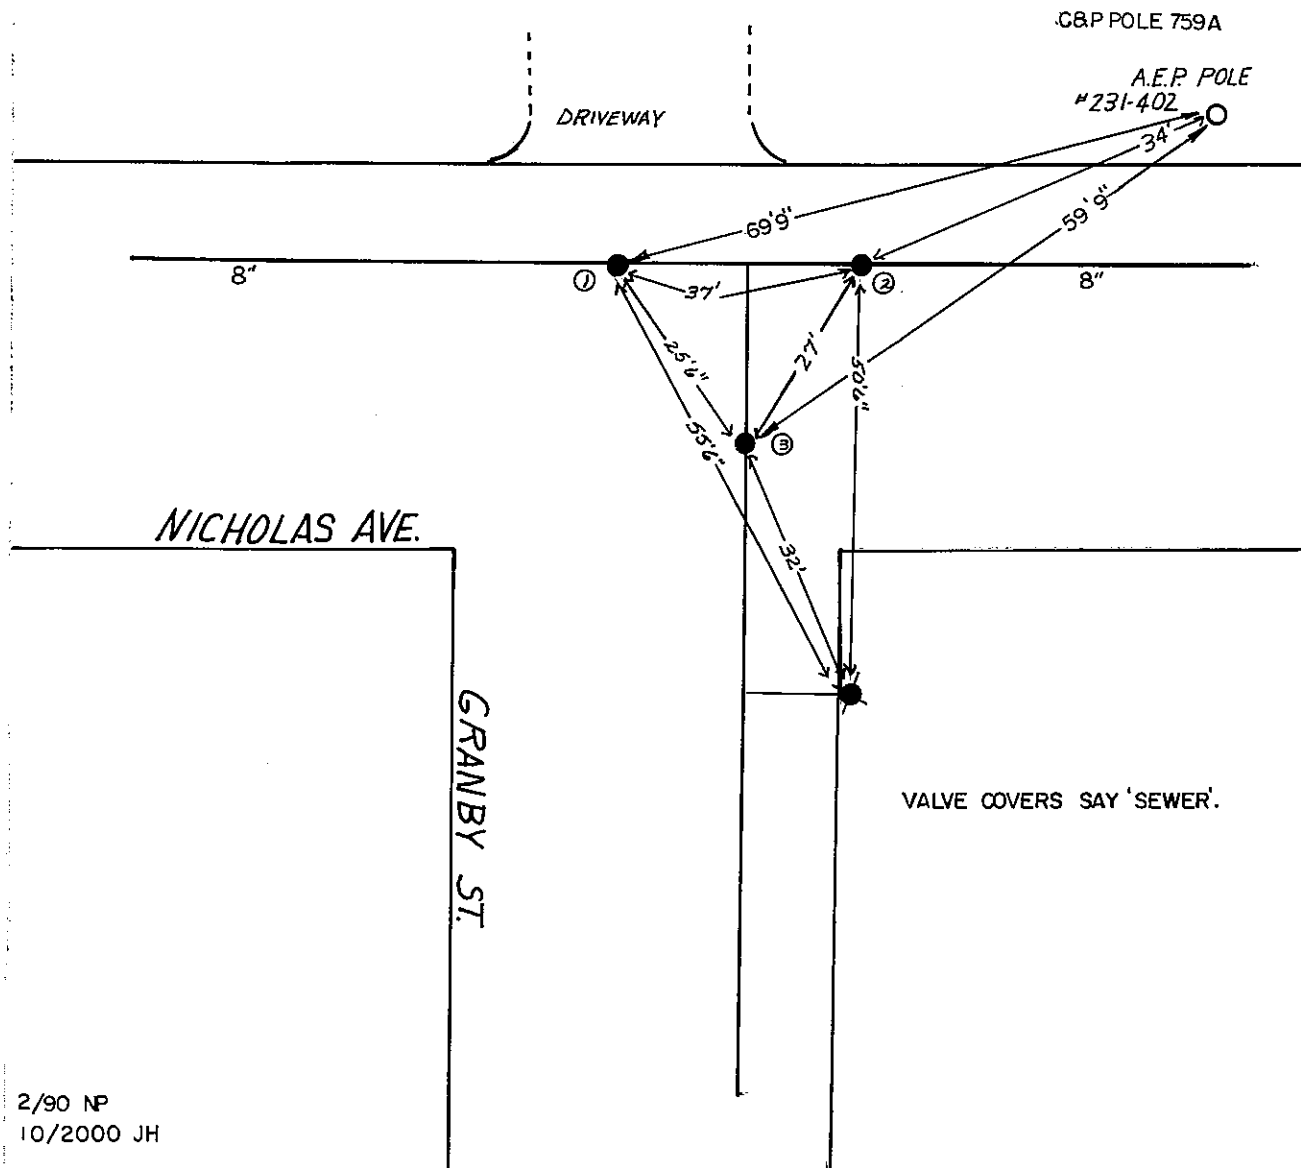

GRANBY ST. AND
NICHOLAS AVE.

719

NE