
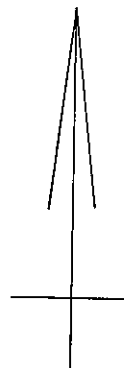


— 2 —

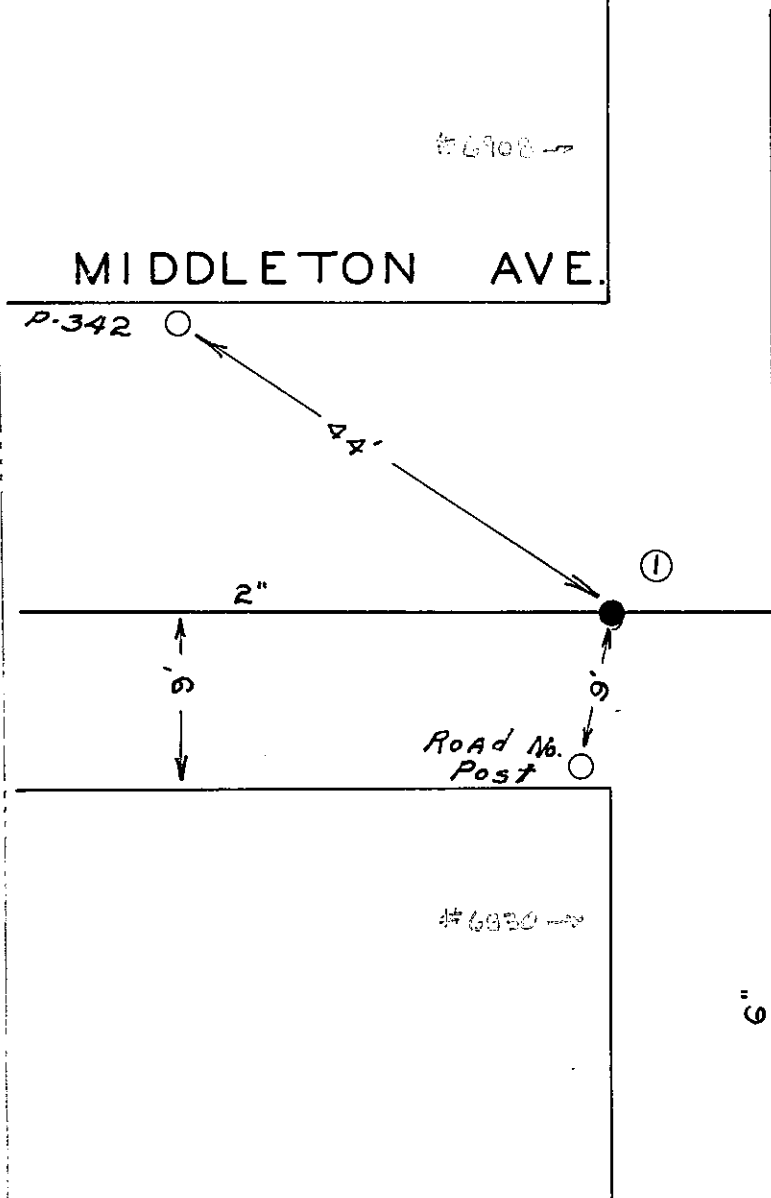

**DRIVE**

# GREENWAY

[illegible]

GREENWAY DRIVE &  
MIDDLETON AVE. N.E.