

0767541


21

STREET

MEADOWCREST

8

8

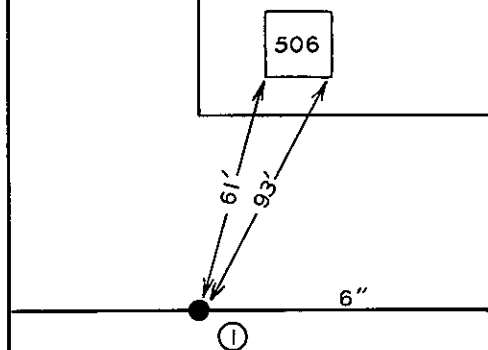

GREENWICH DR.

4
#505

[illegible]

CITY OF ROANOKE—WATER DEP'T
VALVE DIAGRAM

GREENWICH DRIVE &
MEADOWCREST STREET N.E.

SEC. MAP 51 *Remains correct*

DATE	PAGE NO.
------	----------