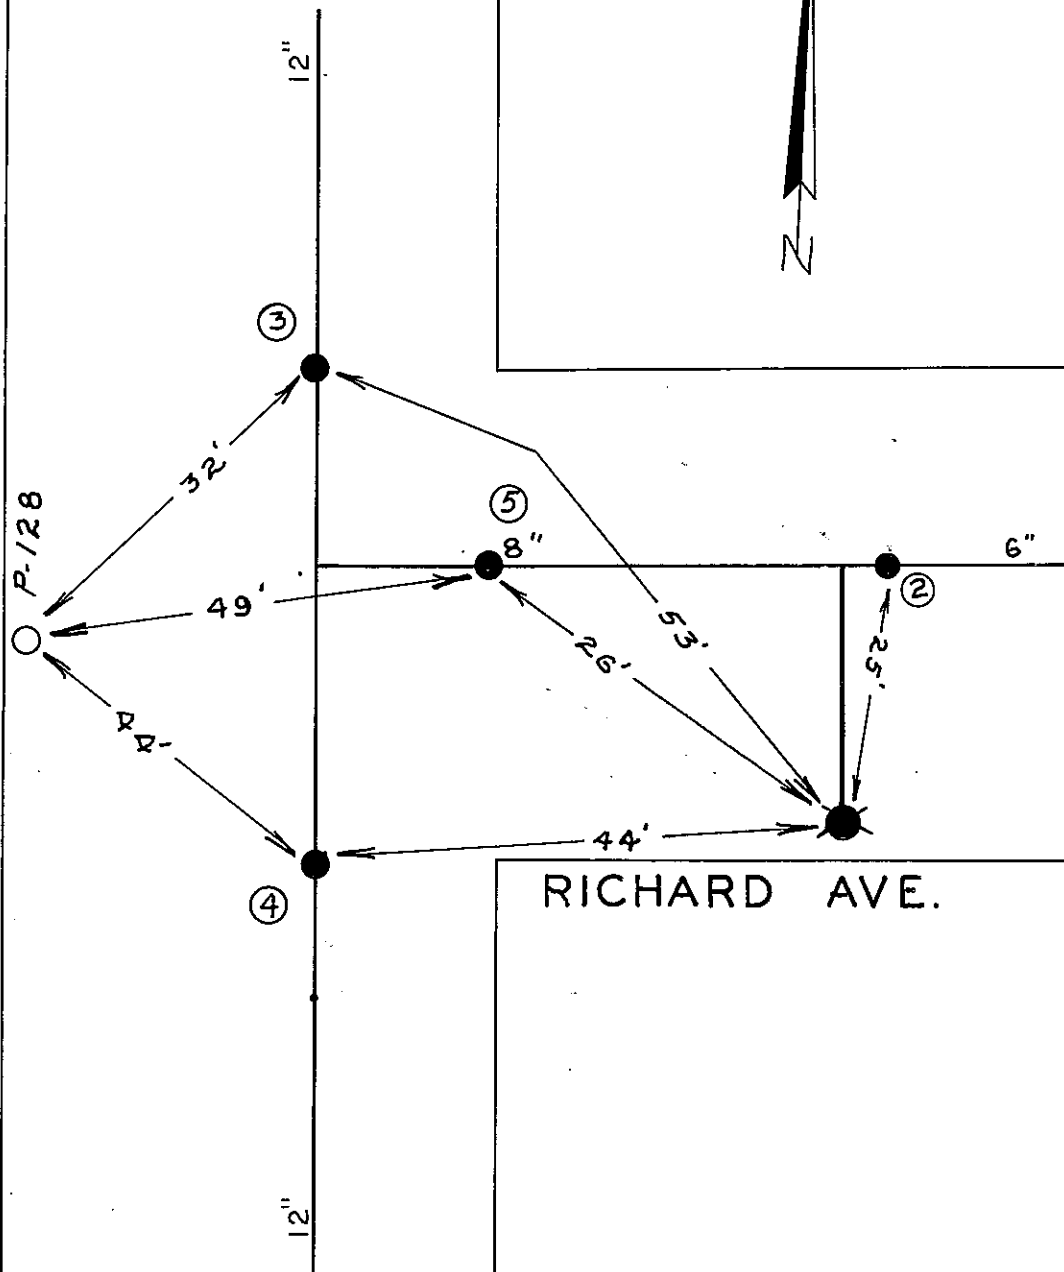


[illegible]

CITY OF CHICAGO - WATER DEPT.
 GUS NICKS Blvd &
 RICHARD AVE. &
 VINTON ROAD
 333 N. E
 DATE PAGE NO.