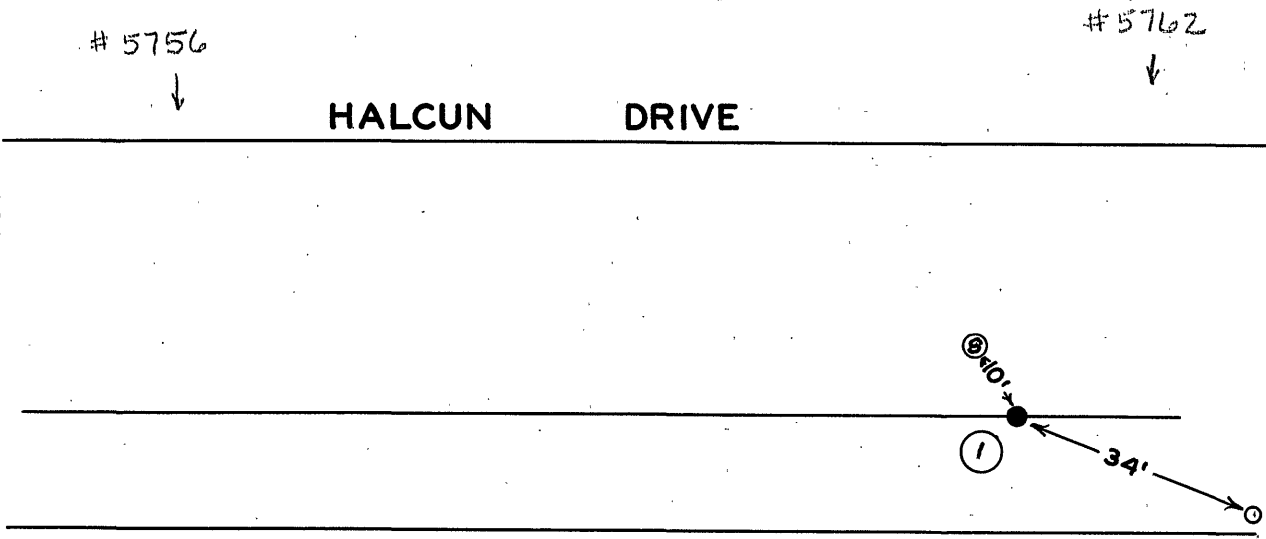


[illegible]

↑ 5739 #

CITY OF ROANOKE — WATER DEPT. VALVE DIAGRAM	
HALCUN DRIVE N.E.	
SEC. MAP	30 & 46 Roanoke County
DATE	PAGE NO.