


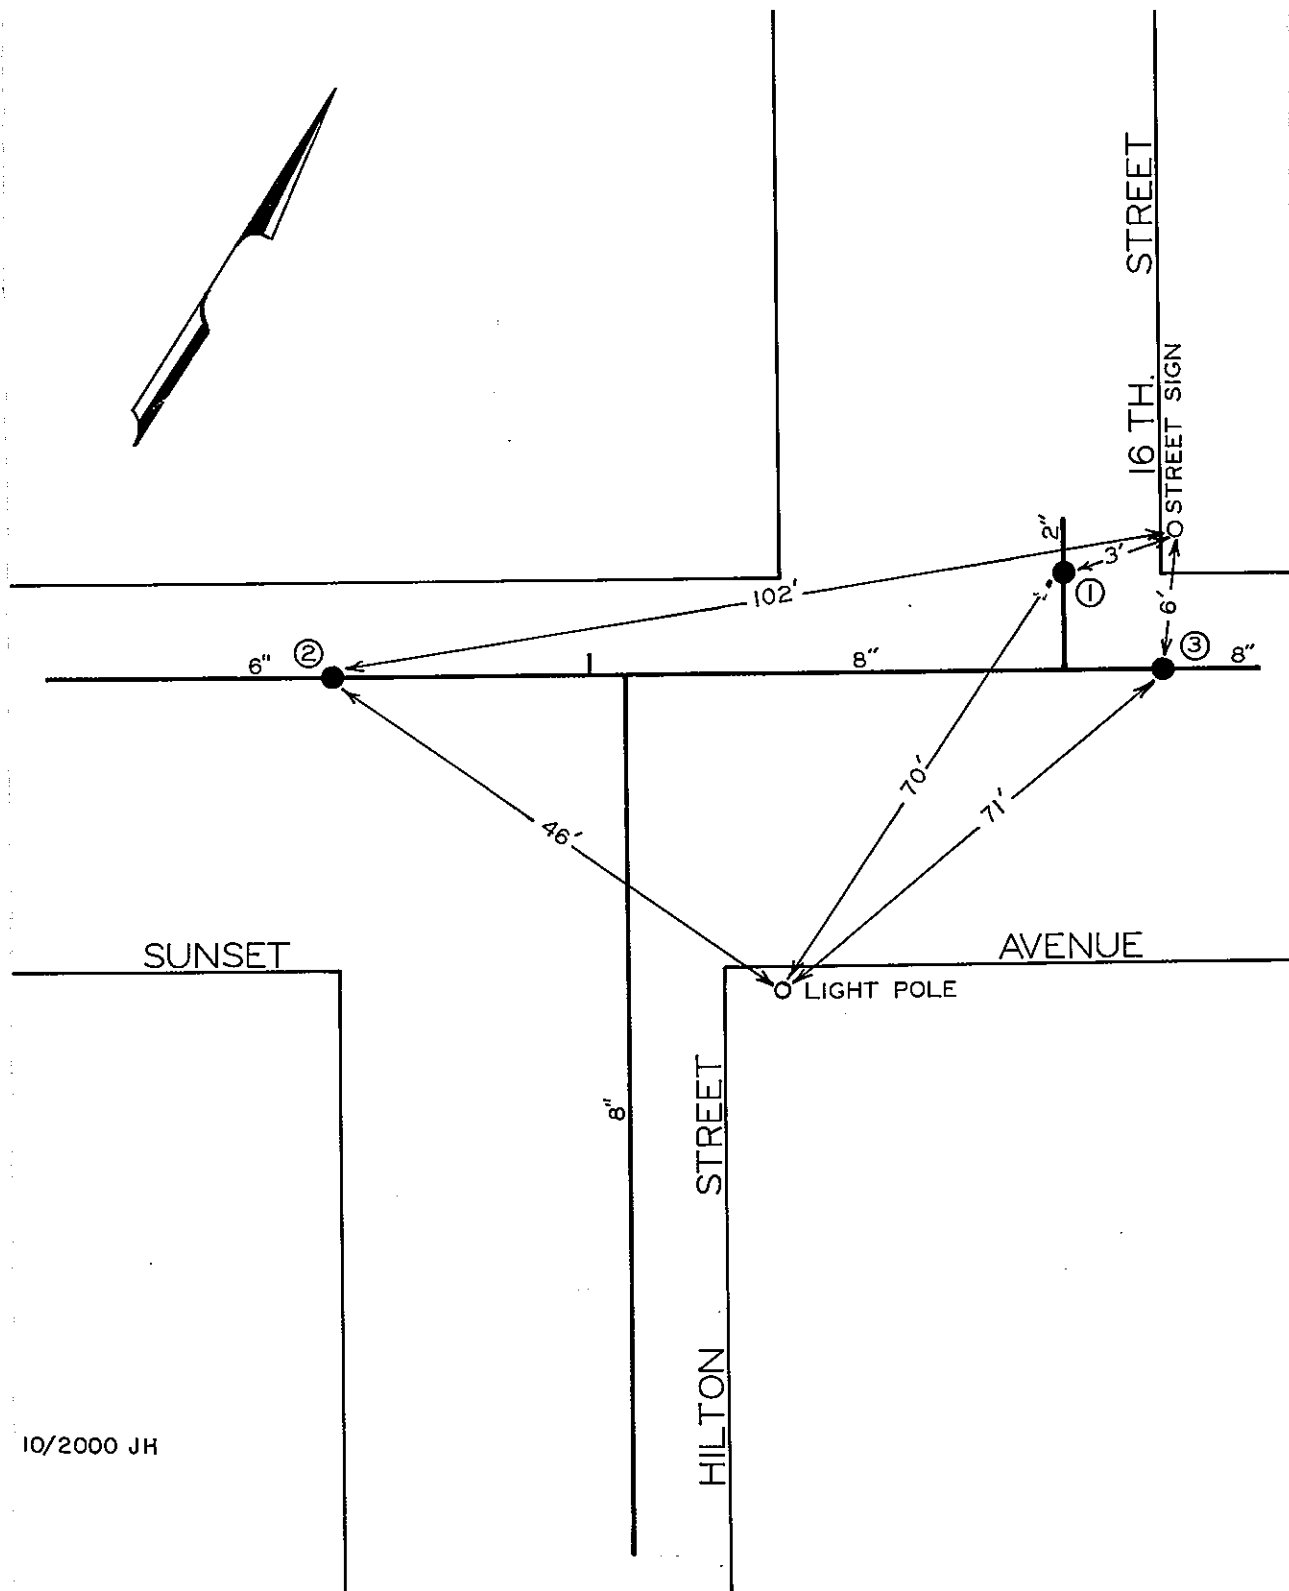

DATE	NO.	TYPE	SIZE	NO.
6-72	1	2"	MUELLER	R
6-72	2	6"	MUELLER	R
6-72	3	8"	MUELLER	R

HILTON STREET, &
 SUNSET AVENUE &
 16 th. STREET
 322 N. E.