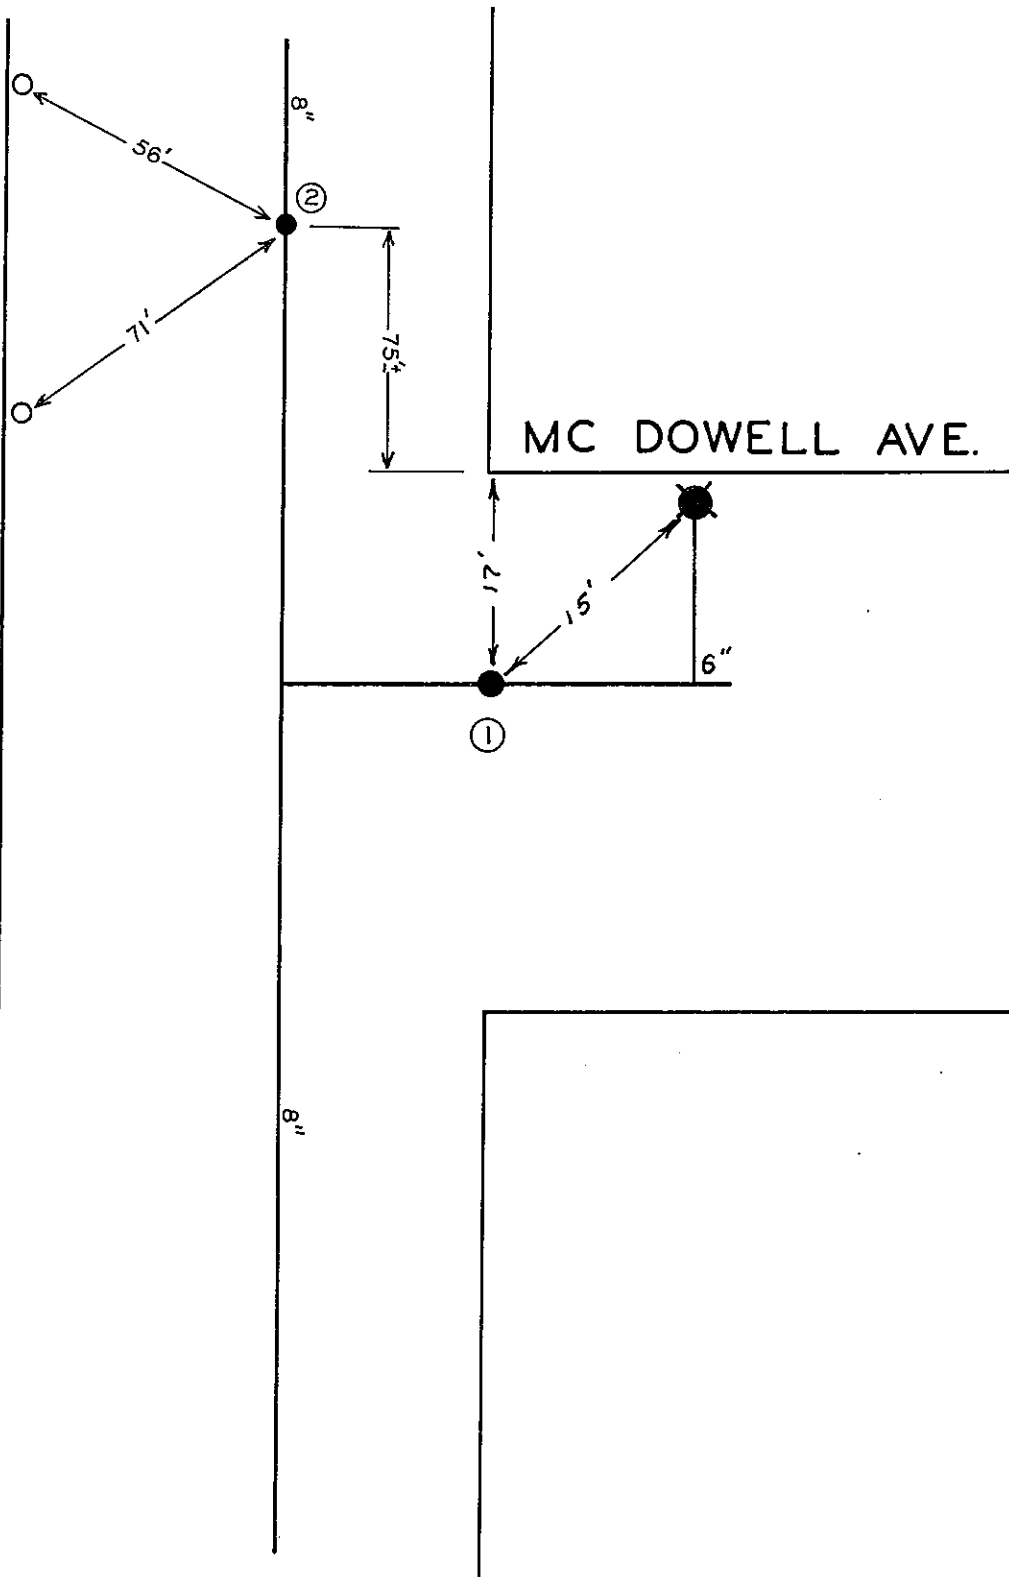


[illegible]

CHIT. OF. 44-38862-1047 ESTE.
VAPLO PLANTING

HOLLINS ROAD &
McDOWELL AVENUE

305 NE

5018 1971 PAGE TWO