


VALVE	SIZE
1	2"
2	12"
3	6"
4	12"

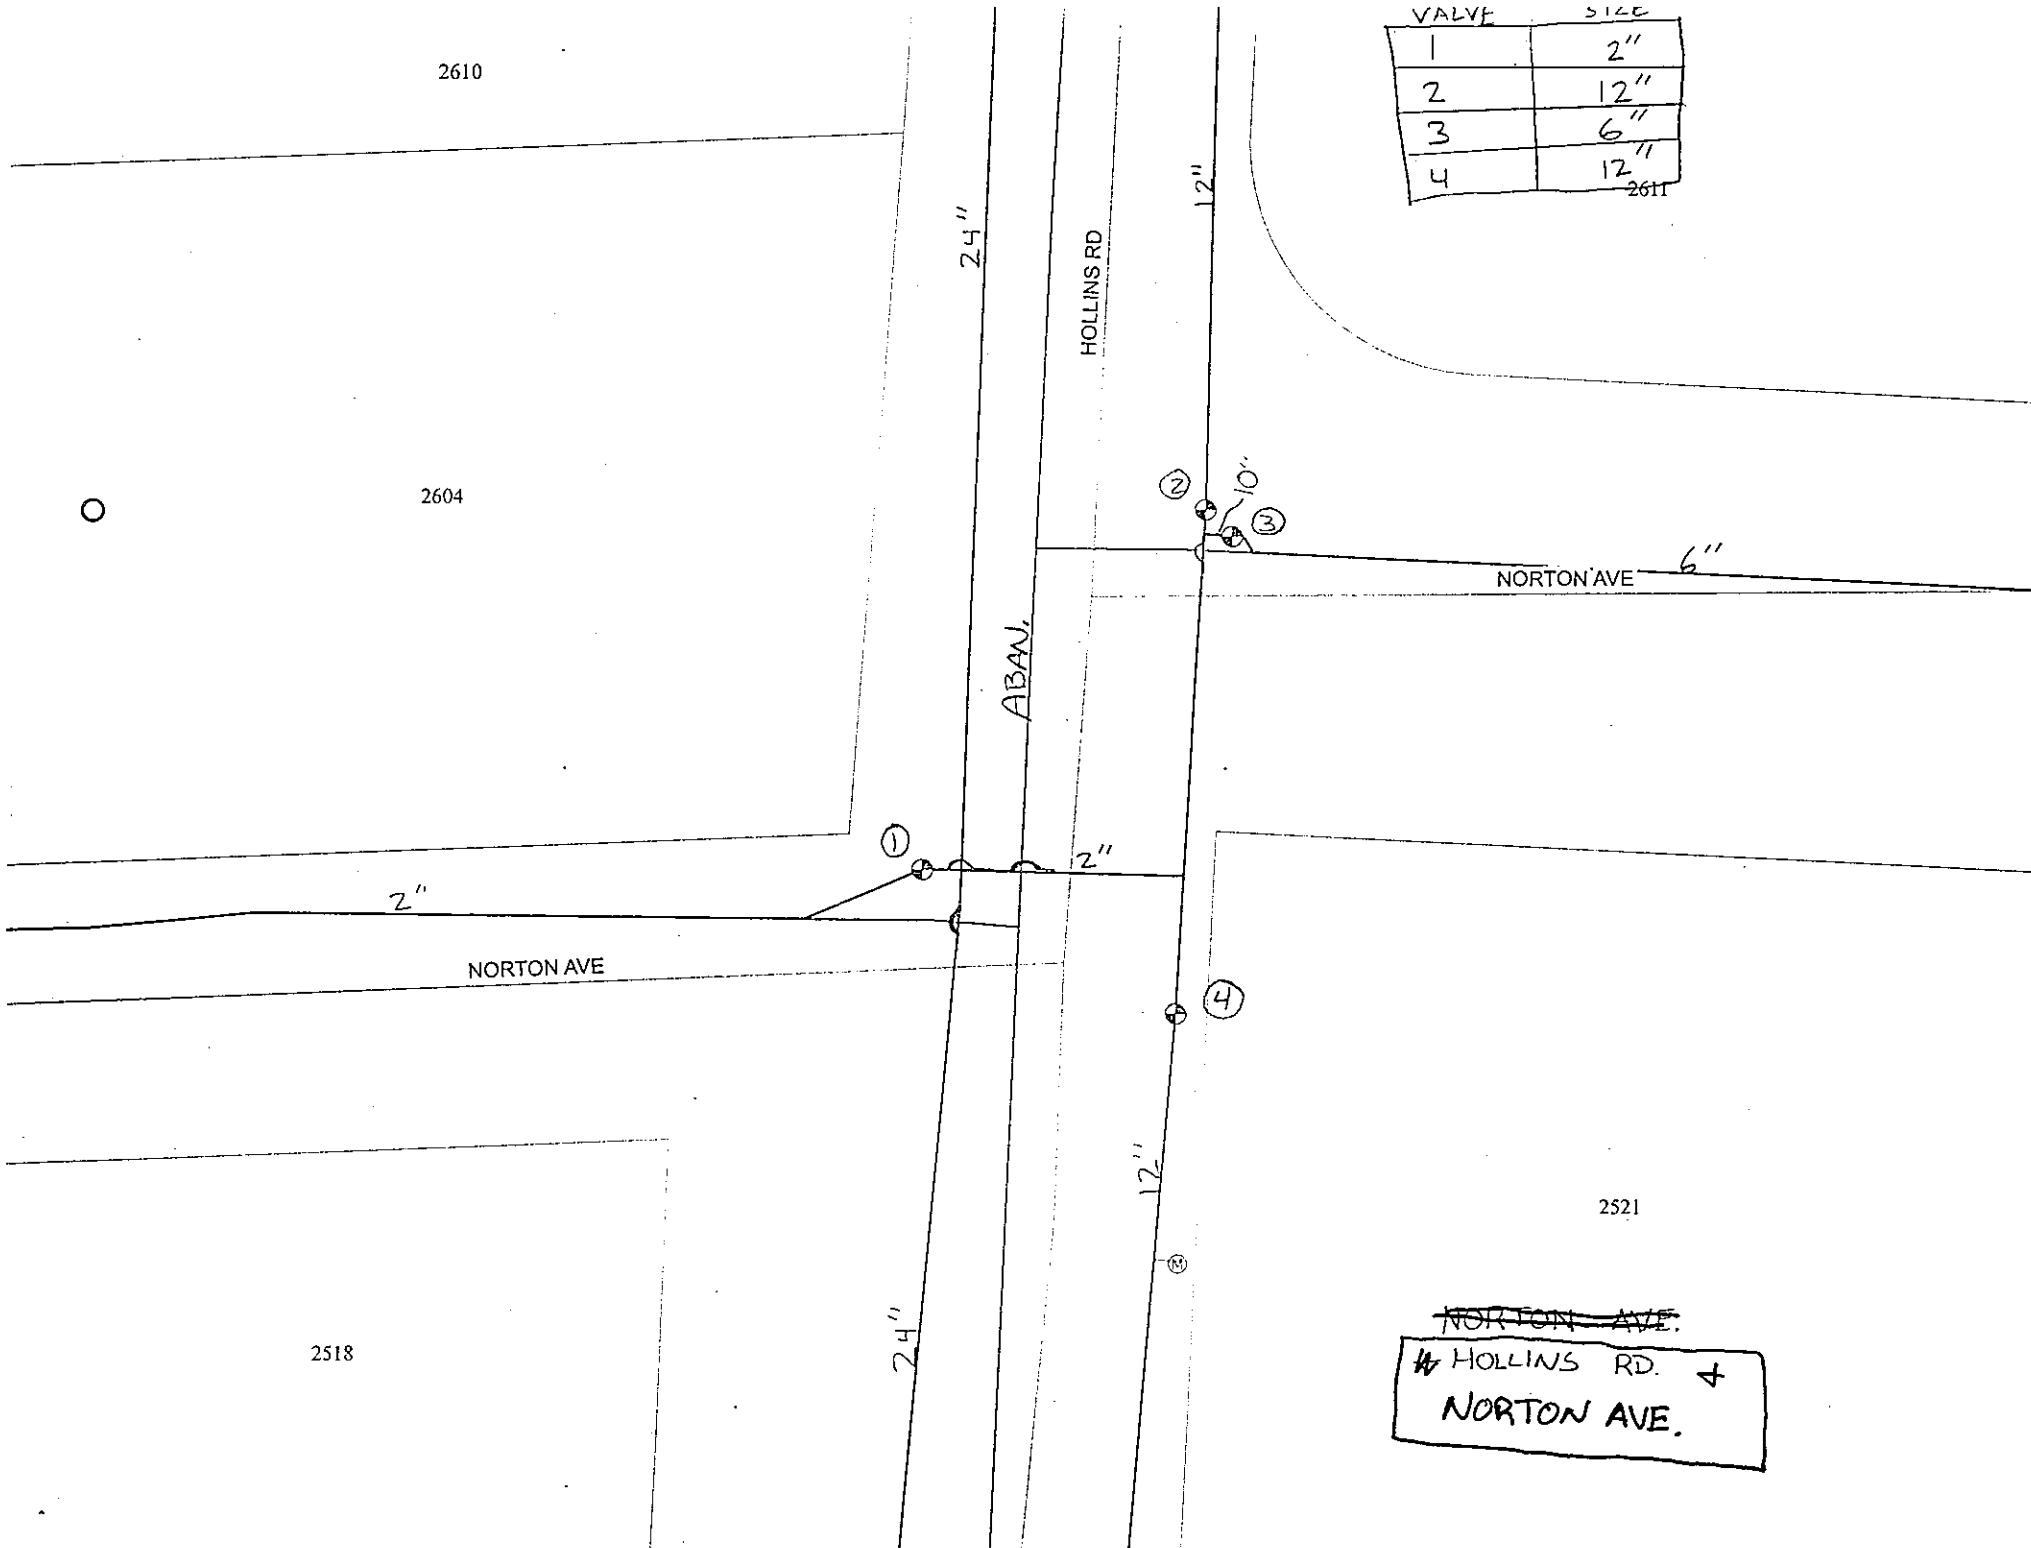

~~NORTON AVE.~~
 # HOLLINS RD. +
 NORTON AVE.