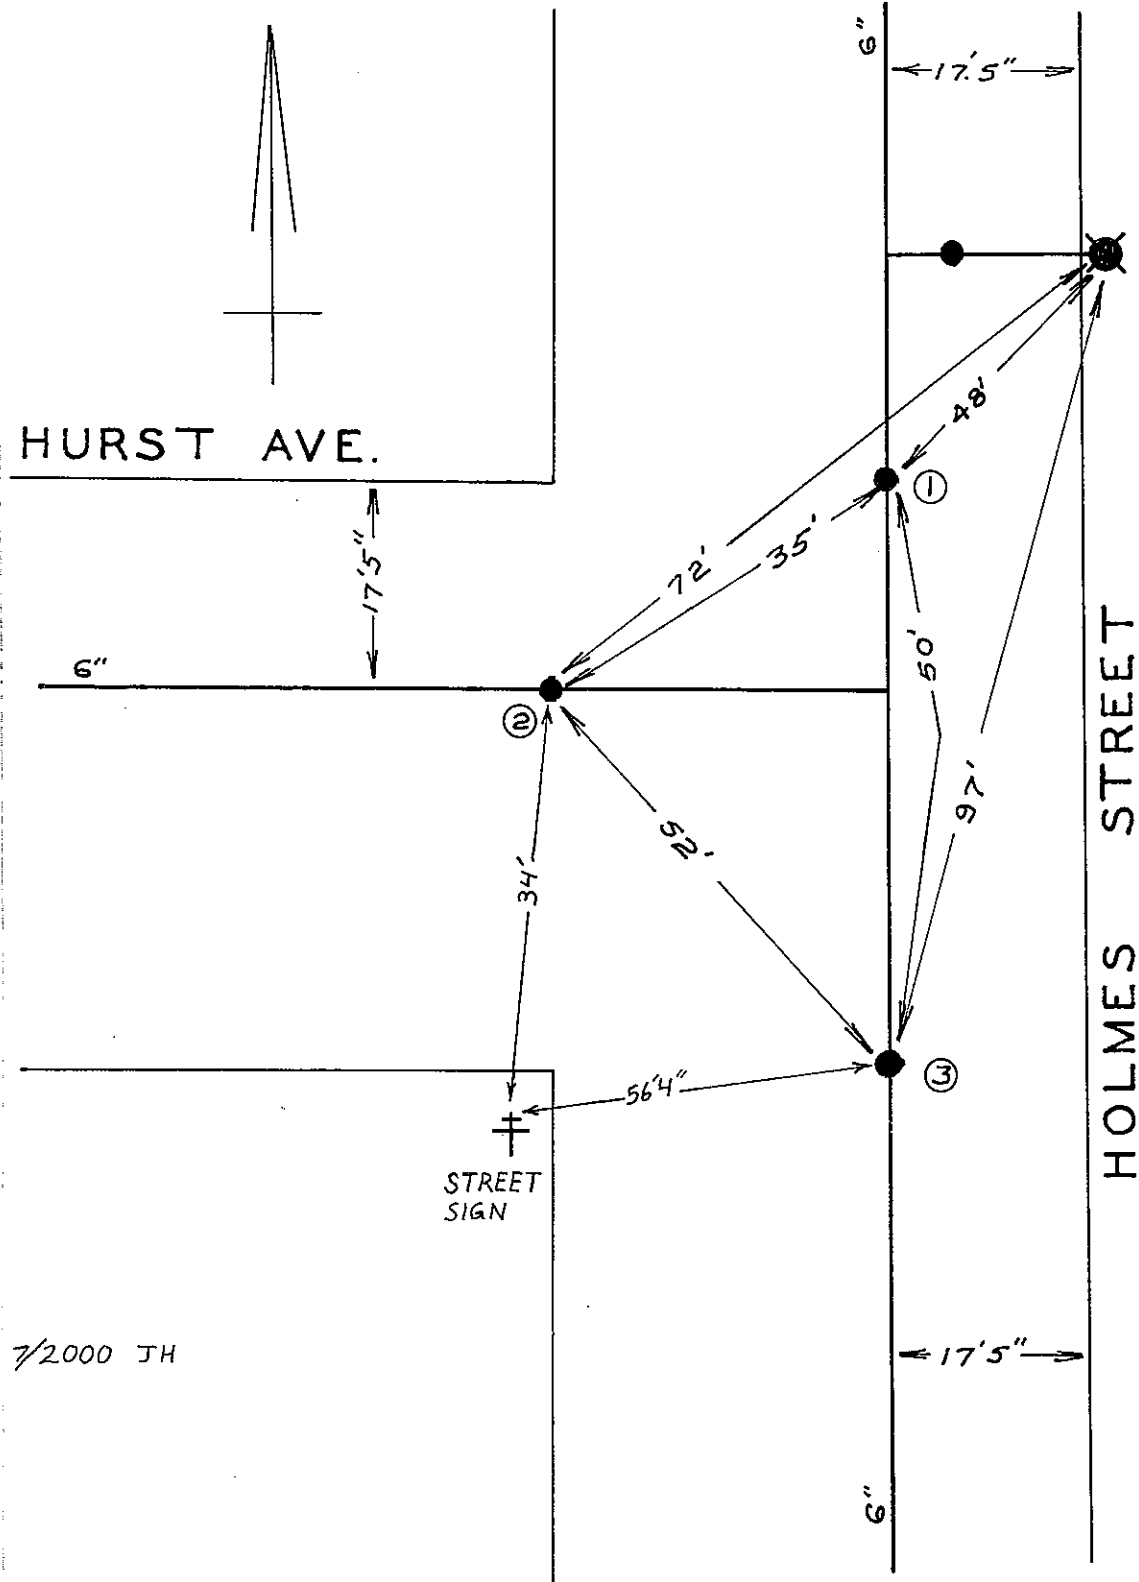


[illegible]

HOLMES ST. & HURST
AVE. N. E.