


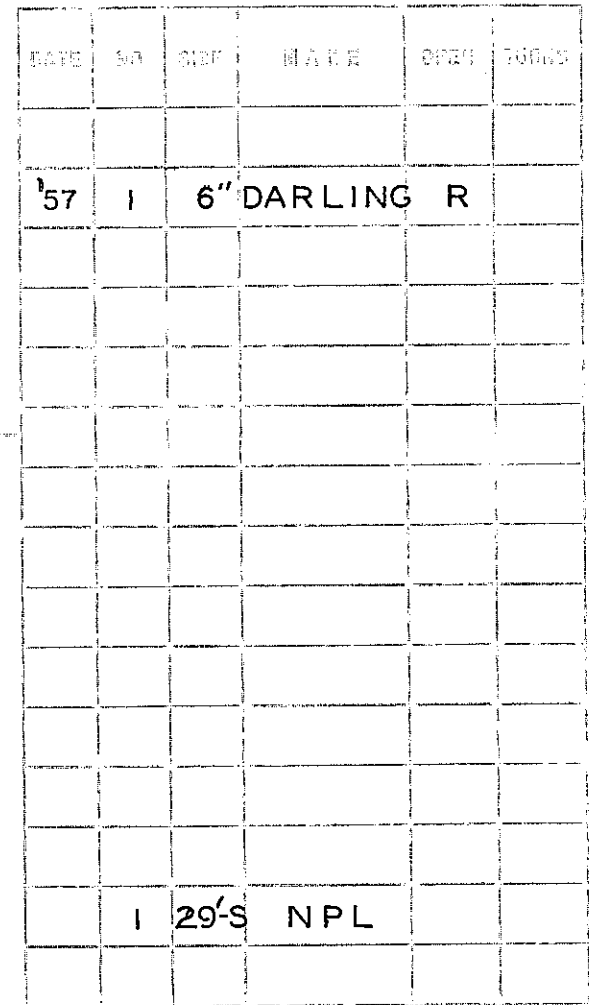

BLVD.

ROAD

PAGE 30 NE188

10/2000 JH