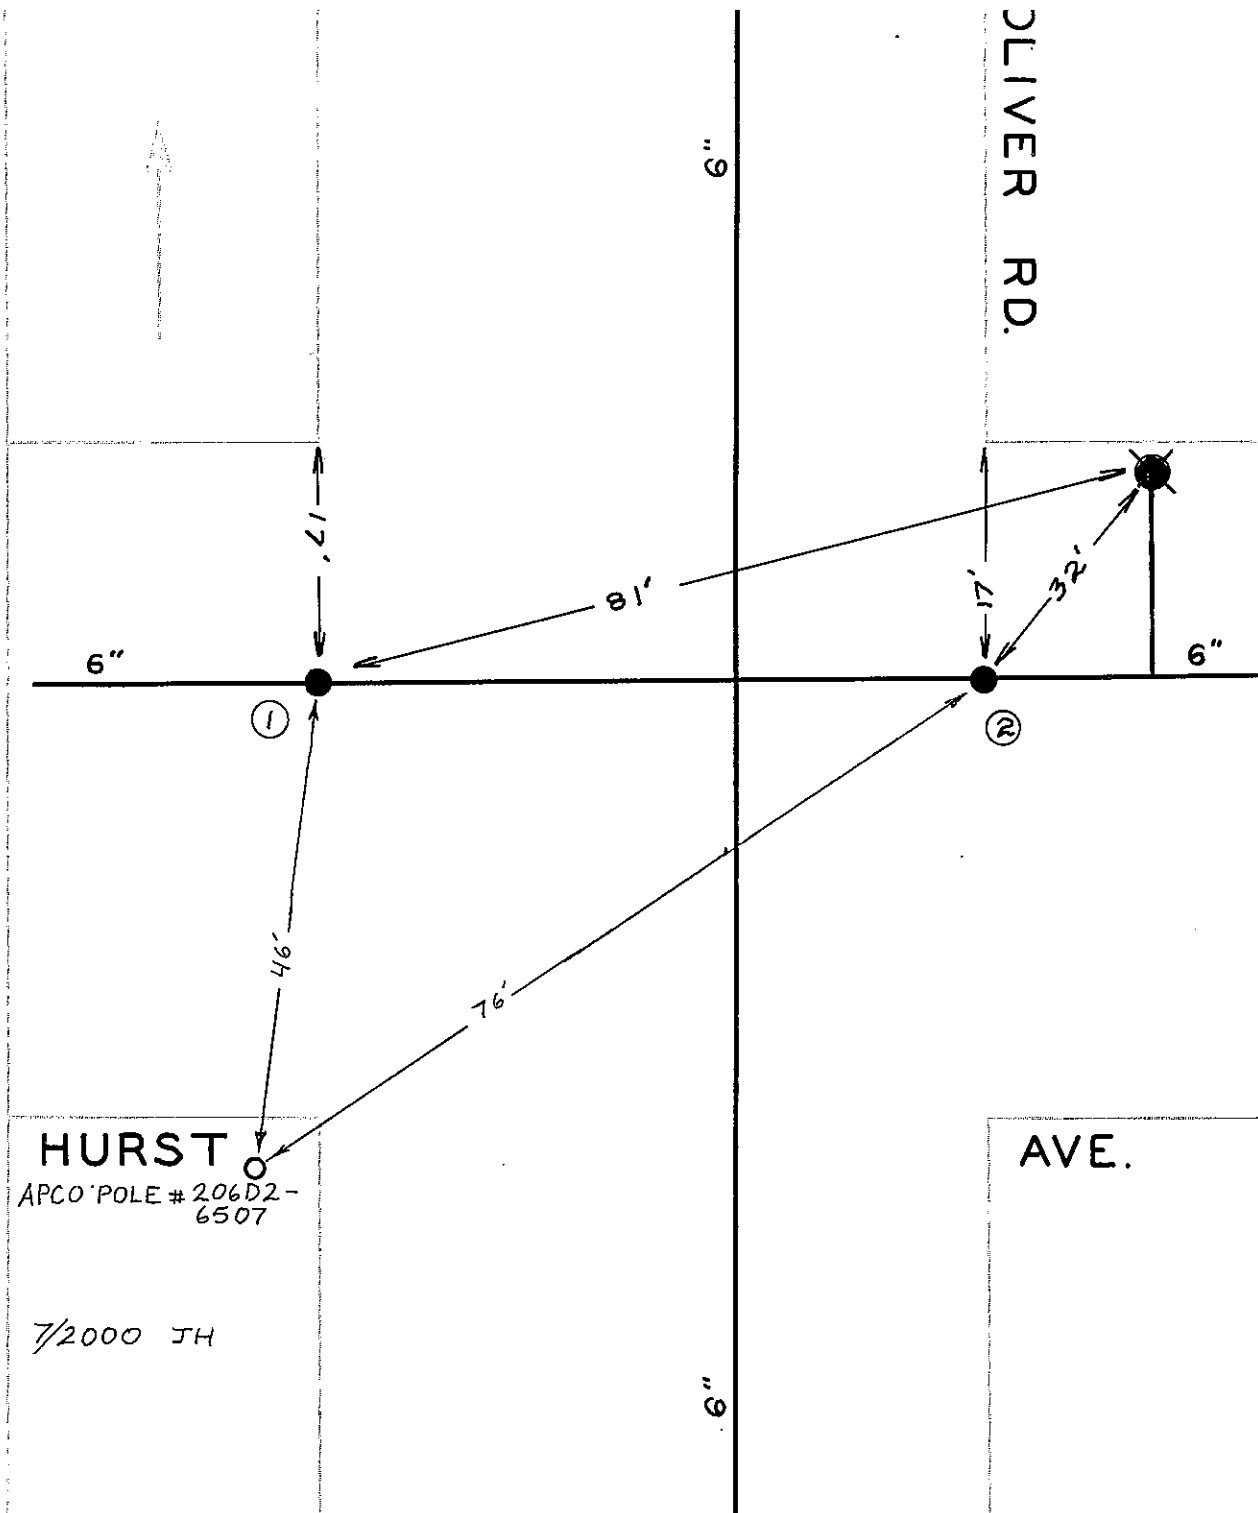


[illegible]CITY OF HOUSTON - WATER DEPT
 BILLING DIVISION

HURST AVE. & OLIVER
ROAD N. E.

319

DATE _____

$\left\{ \begin{array}{l} \text{if } \text{is_empty}(A) \text{ then } \text{return } \text{true} \\ \text{if } \text{is_empty}(B) \text{ then } \text{return } \text{false} \\ \text{if } \text{is_empty}(A \cup B) \text{ then } \text{return } \text{true} \\ \text{if } \text{is_empty}(A \cap B) \text{ then } \text{return } \text{false} \\ \text{if } \text{is_empty}(A \setminus B) \text{ then } \text{return } \text{true} \\ \text{if } \text{is_empty}(B \setminus A) \text{ then } \text{return } \text{false} \\ \text{if } \text{is_empty}(A \oplus B) \text{ then } \text{return } \text{true} \\ \text{if } \text{is_empty}(A \cap B) \text{ then } \text{return } \text{false} \\ \text{if } \text{is_empty}(A \setminus B) \text{ then } \text{return } \text{true} \\ \text{if } \text{is_empty}(B \setminus A) \text{ then } \text{return } \text{false} \\ \text{if } \text{is_empty}(A \oplus B) \text{ then } \text{return } \text{true} \end{array} \right.$