


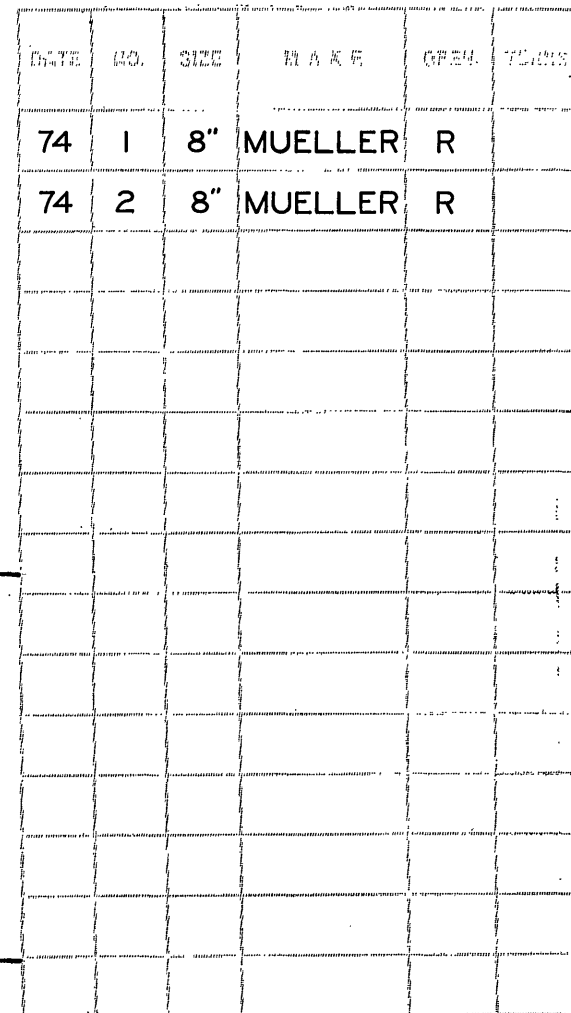

2 23. 06. 1970 10. 00  
1 23. 06. 1970 10. 00

11/2000 JH