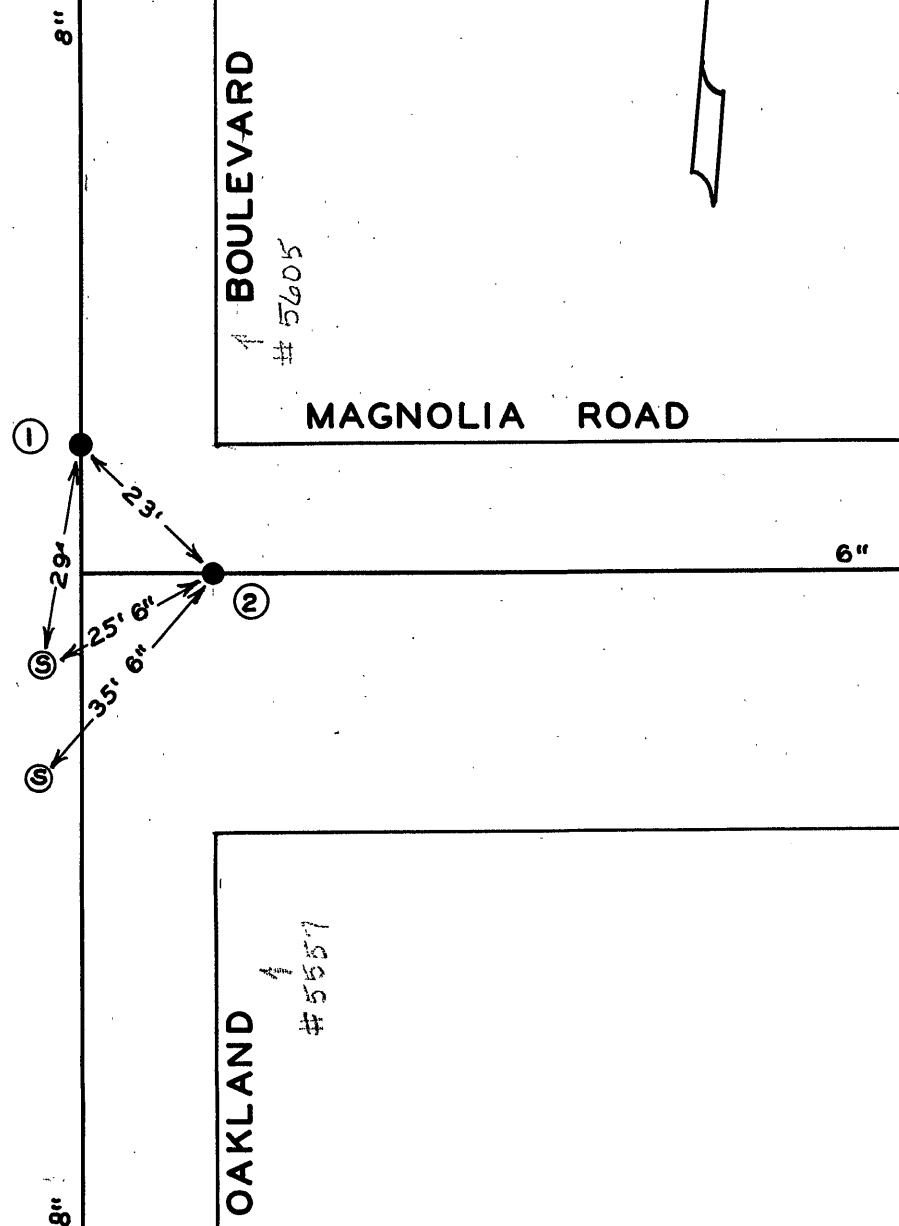


[illegible]

CITY OF ROANOKE—WATER DEPT. VALVE DIAGRAM

MAGNOLIA ROAD &
OAKLAND BOULEVARD N.E.

SEC. MAP 30 Roanoke County

DATE _____ PAGE NO. _____