


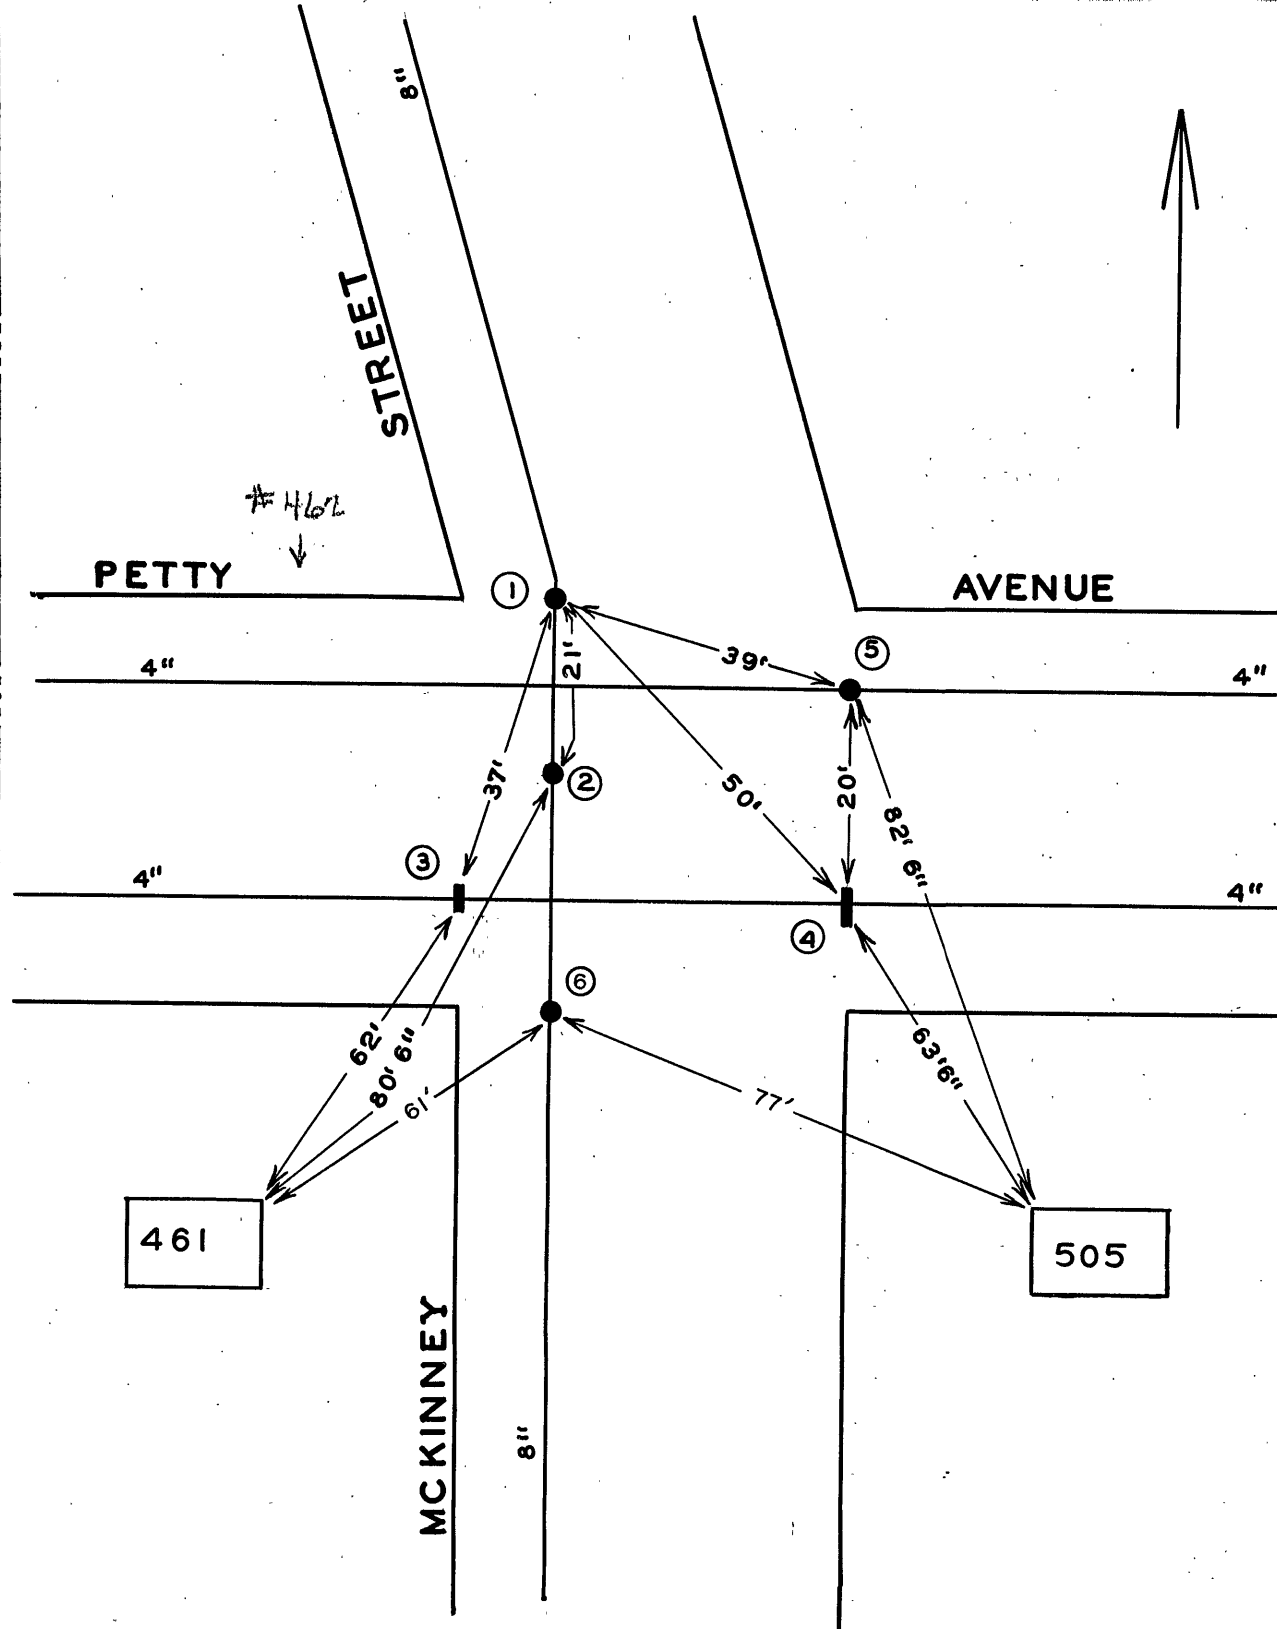

DATE	NO.	SIZE	MAKE	OPEN	TURNS
12-63	1	8"	MUELLER	R	27
12-63	2	8"	MUELLER	R	27
12-63	3	4"	MUELLER	R	15
12-63	4	4"	MUELLER	R	15
12-63	5	4"	MUELLER	R	15
9-69	6	8"	MUELLER	R	27
	1	0	N.P.L.		
	2				
	3	0	W.P.L.		
	4	0	E.P.L.		
	5	0	E.P.L.		
	6	8' N	S.P.L.		

CITY OF ROANOKE - WATER DEPT.	
VALVE DIAGRAM	
MCKINNEY STREET &	
PETTY AVENUE N.E.	
SEC. MAP 46 Roanoke County	
DATE	PAGE NO.