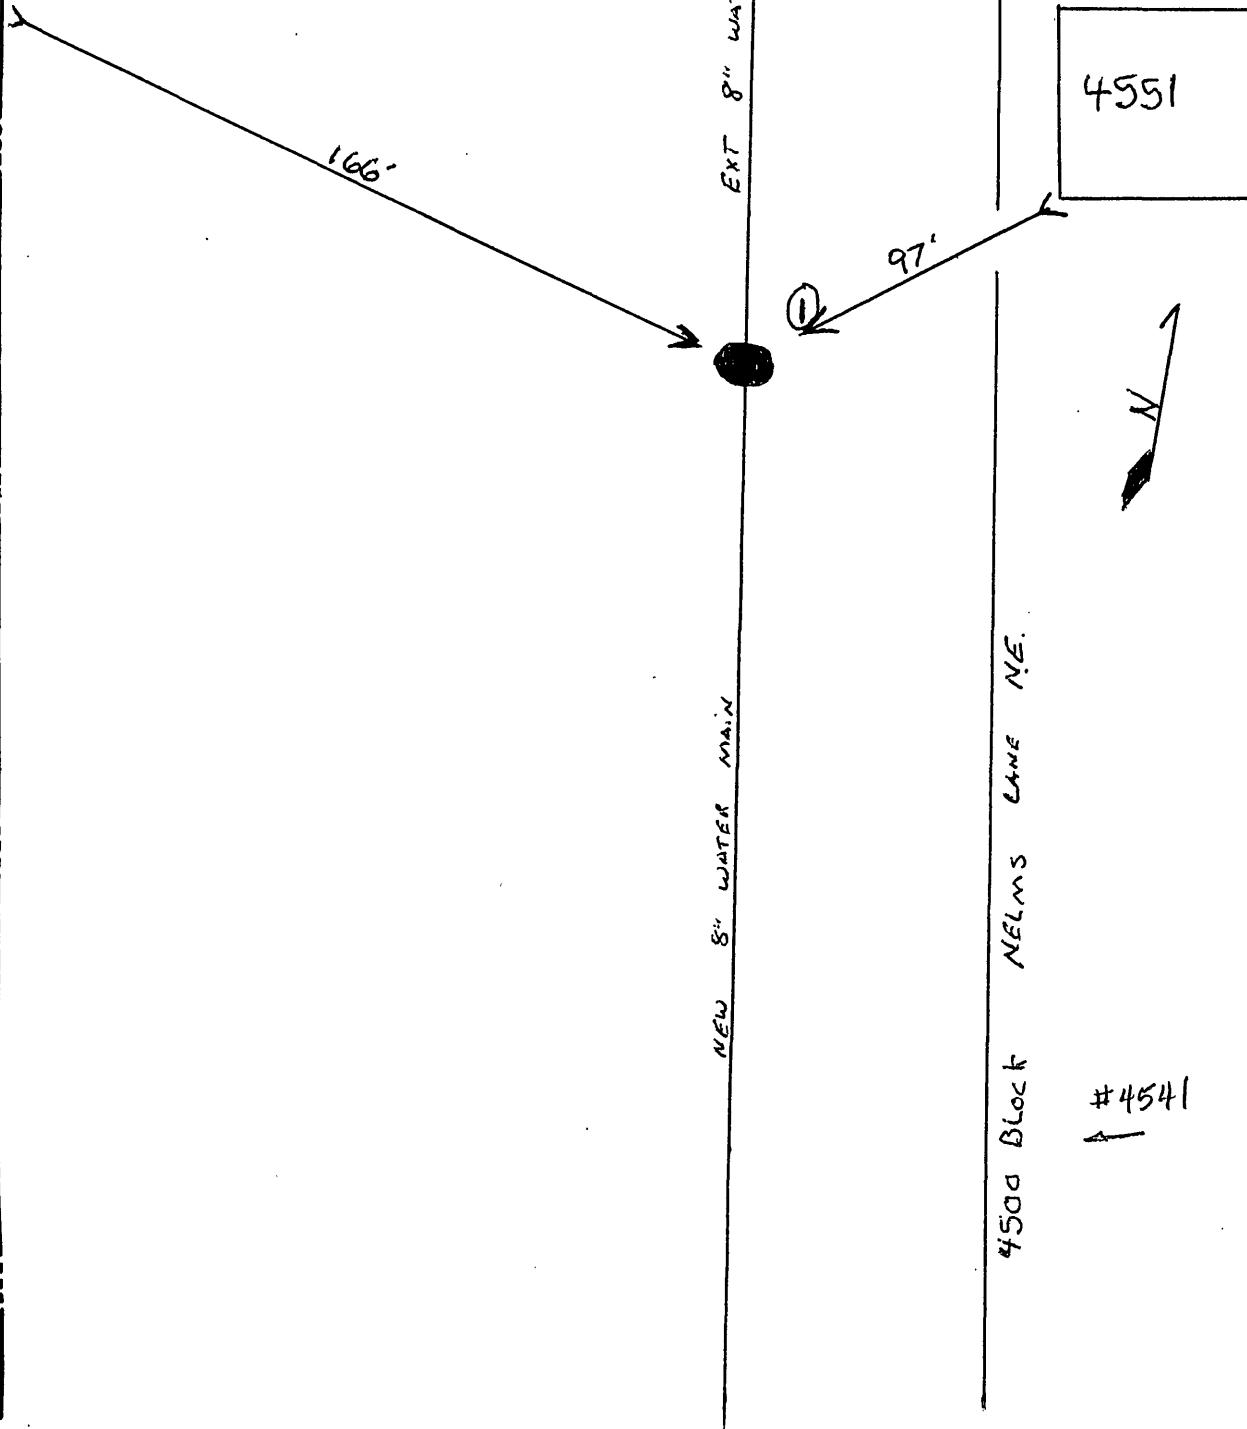


0

[illegible]

CITY OF ROANOKE—WATER DEPT VALVE DIAGRAM

4551 NEELMS LANE

SEC. MAP 739

DATE 10-97 PAGE NO.