


EXT. 8" WATER MAIN

DRIVE WAY

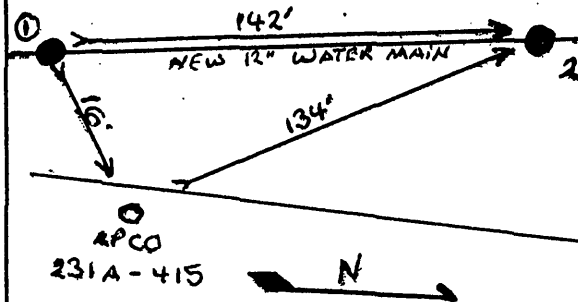

3030

[illegible]

3030 NICHLOAS AVE NE

SEC. MAP. 721

DATE 2/98

PAGE NO.