


#432 →

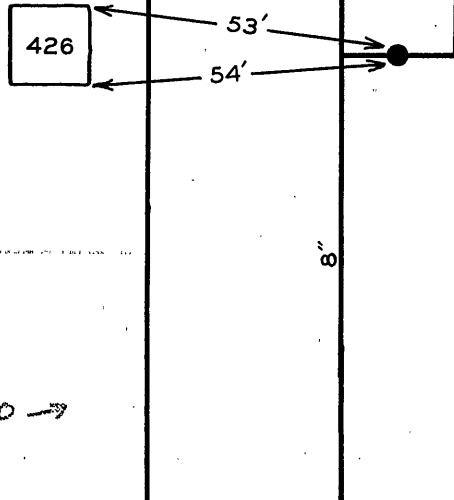

#420 →

AVENUE

PETTY

← #431

DATE	NO.	SIZE	M A K E	OPEN	TURNS
69	1	4"			

CITY OF ROANOKE—WATER DEPT
VALVE DIAGRAM

PETTY AVENUE N.E.

CROSS OVER VALVE

SEC. MAP 46 Roanoke County

DATE

PAGE NO.