


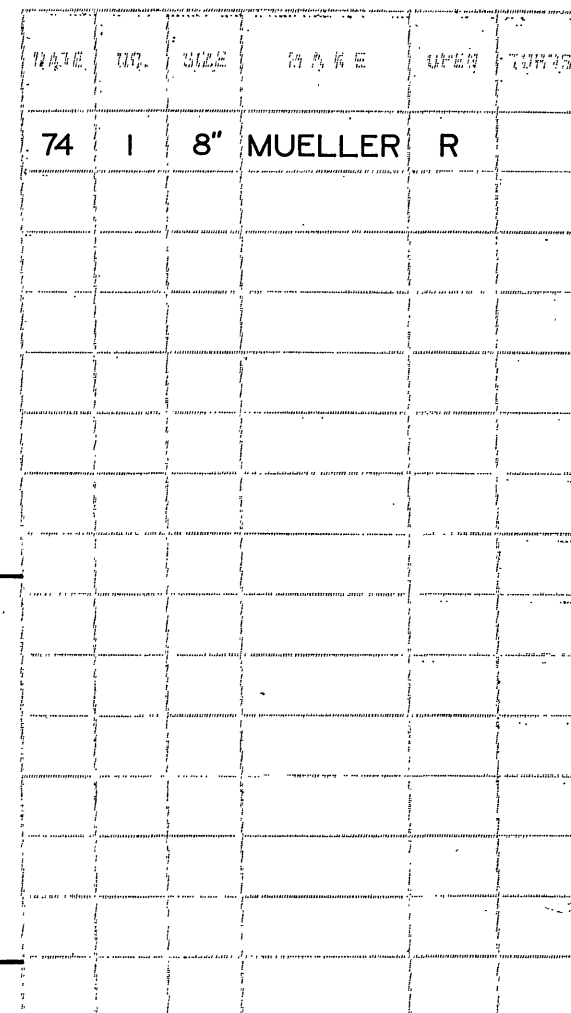

THE UNIVERSITY OF CHICAGO

11/2000 JH