


IMPERIAL TRADING CO. INC.
K E E C O., N. Y.

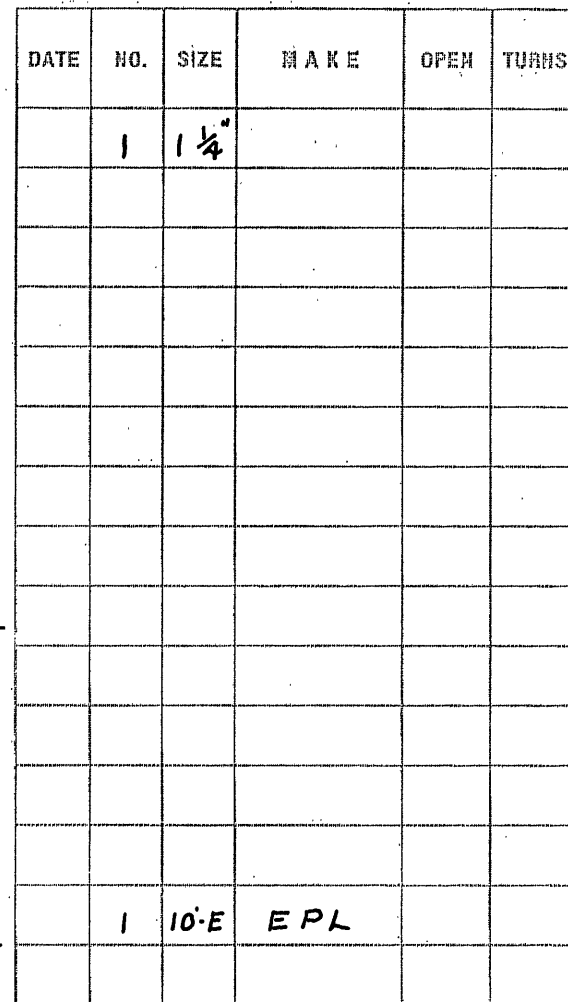

YEAGER AVE. & 21 ST.
STREET N.E.

SEC. MAP 334

DATE _____

PAGE NO.