


95201

10241

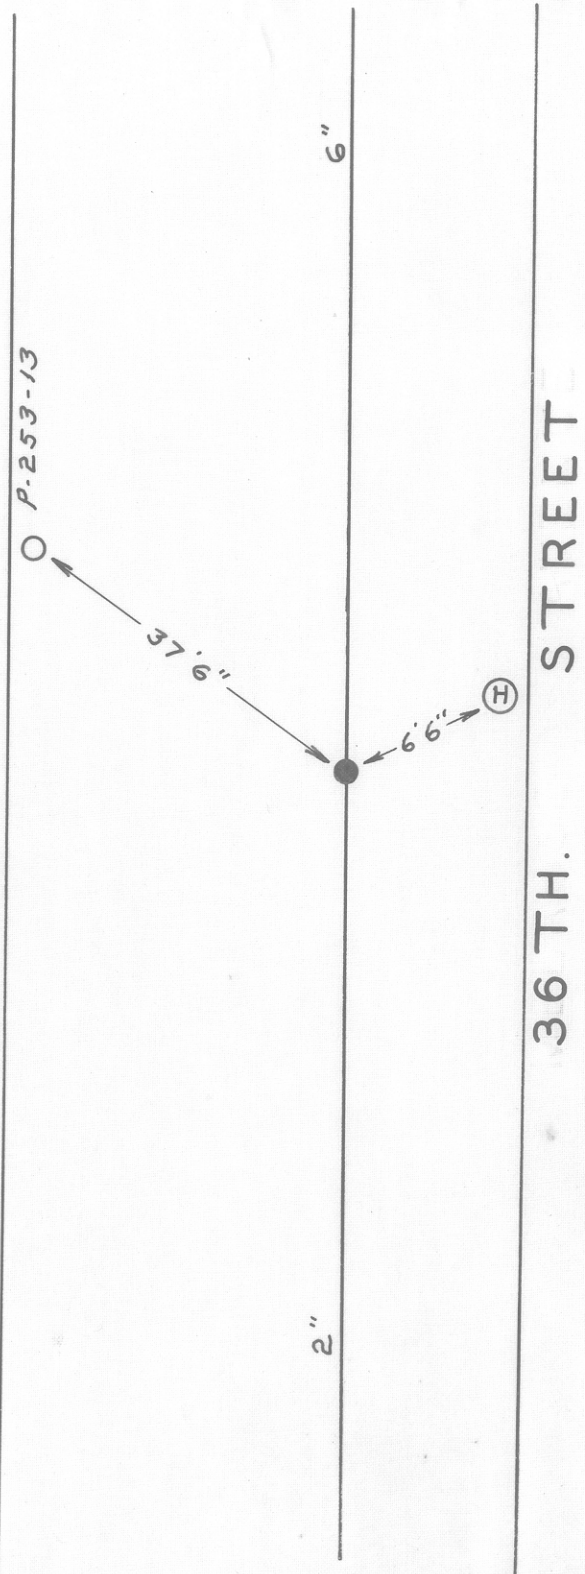

CITY OF ROANOKE—WATER DEPT.
VALVE DIAGRAM

36 TH. ST. N.W. 506'
S. OF MELROSE AVE.

SEC. MAP 266

N.W.V

DATE _____

PAGE NO.