


10/94 NP
1/95 NP

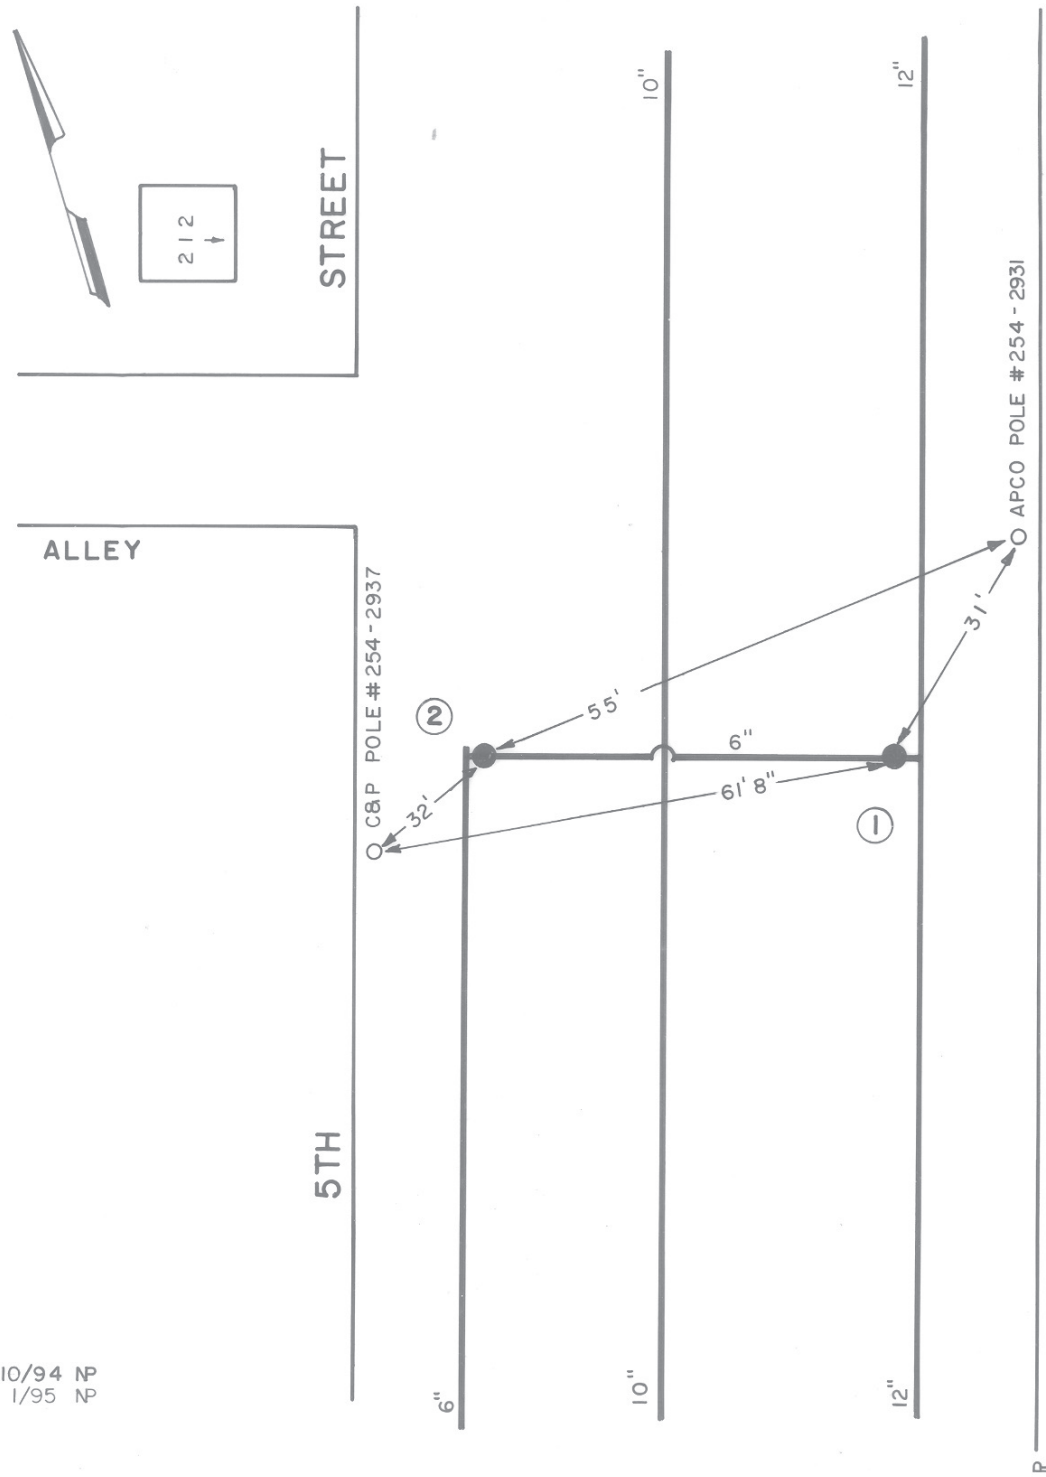

COCA-COLA PLANT

DATE	NO.	SIZE	MAKE	OPEN	TURNS
1994	1	6"		R	20
1994	2	6"		R	20

CITY OF ROANOKE - WATER DEP'T.	
VALVE DIAGRAM	
5TH STREET	
200 BLOCK	
NEAR ALLEY	
SEC. MAP 201	NW
DATE:	PAGE NO.