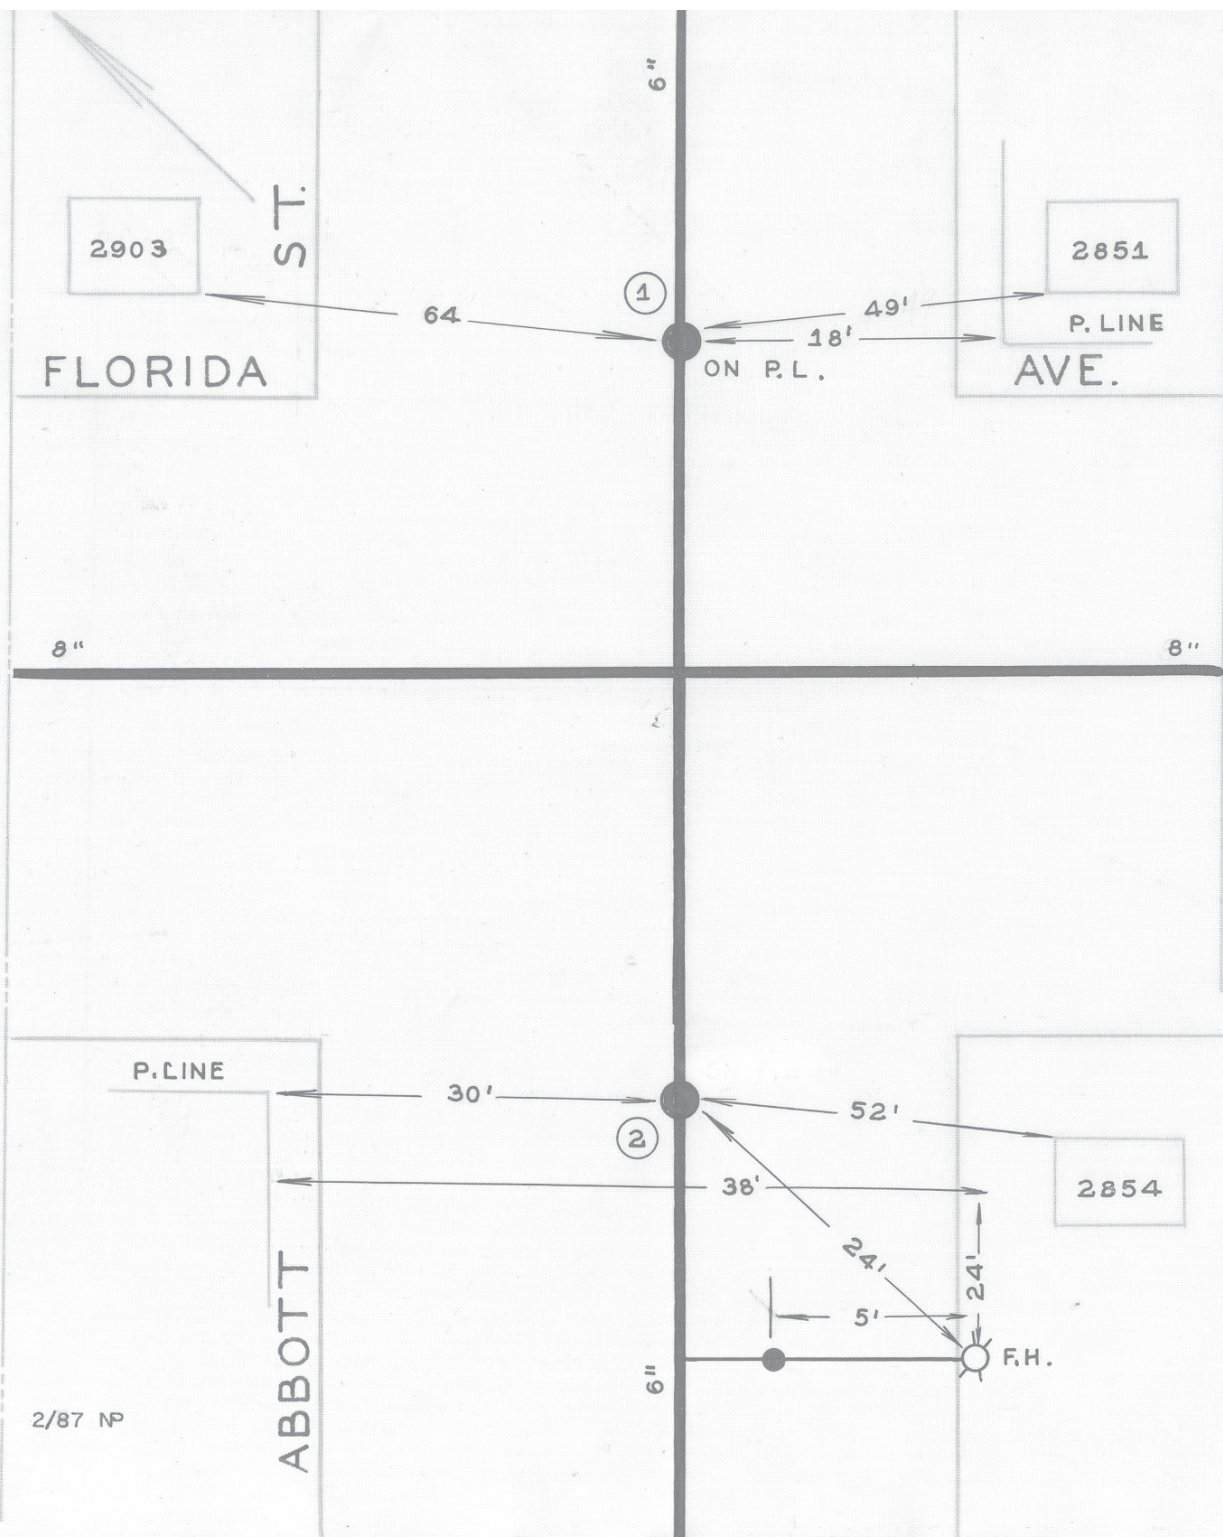


[illegible]

CITY OF ROANOKE—WATER DEP'T
VALVE DIAGRAM

ABBOTT STREET &
FLORIDA AVENUE N.W.

SEC. MAP 246

DATE _____ PAGE NO. **N.W.356**