


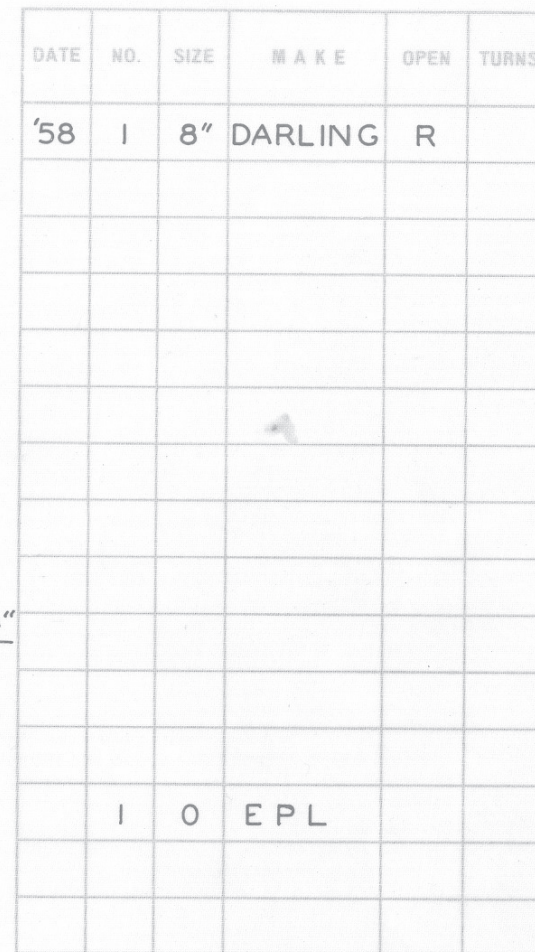

1052
1054

11/2000 JH

PAGE NO.