


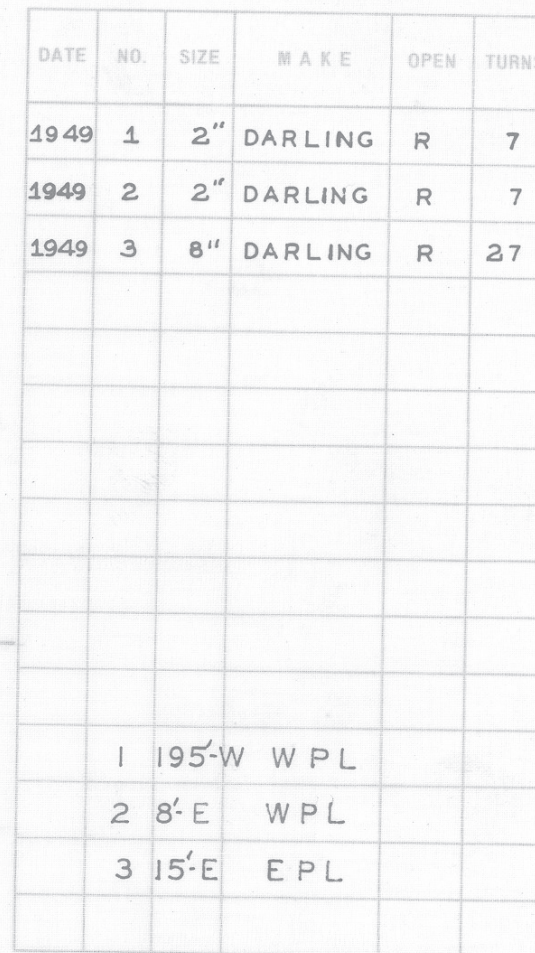

PAGE NO. N.W.317