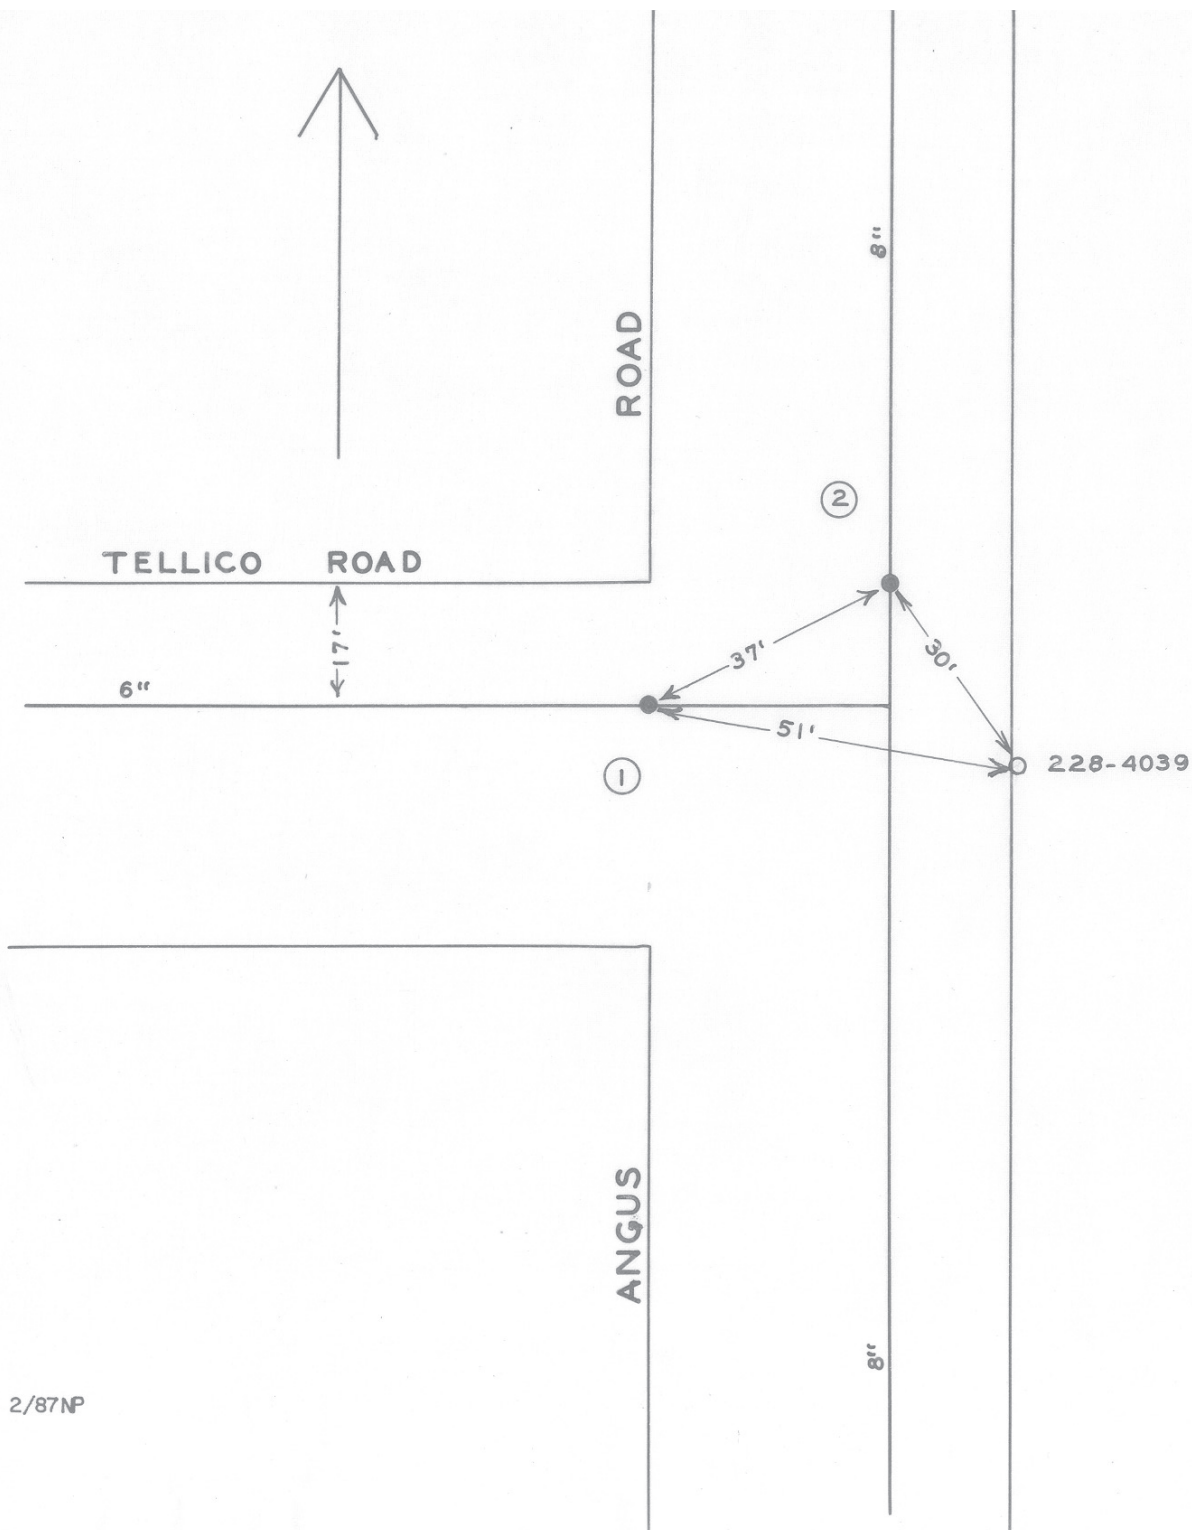


[illegible]

CITY OF ROANOKE — WATER DEPT.	
VALVE DIAGRAM	
ANGUS ROAD	& TELlico
TELLICO ROAD	
N.W.	
SEC. MAP	637
DATE	PAGE NO.