


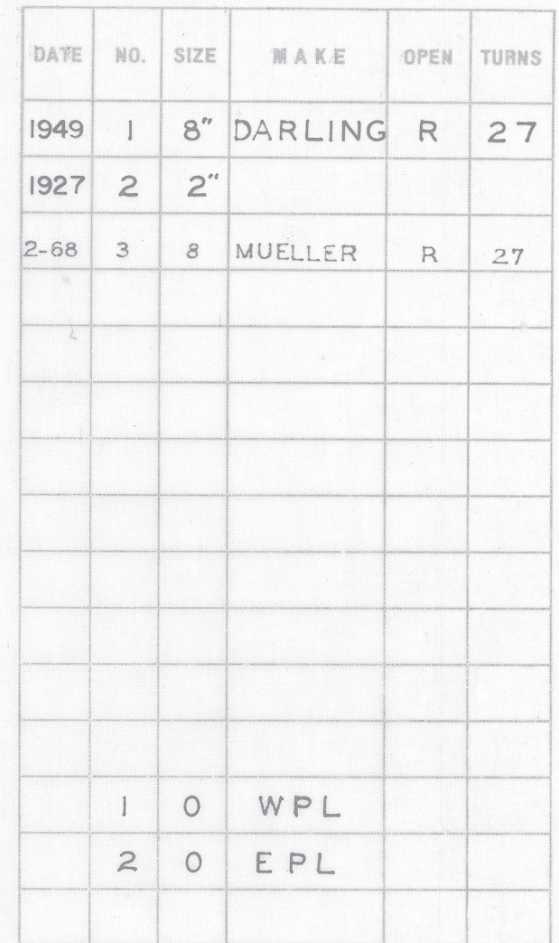

SEC. MAP 244,246	N.W.
DATE	PAGE NO.