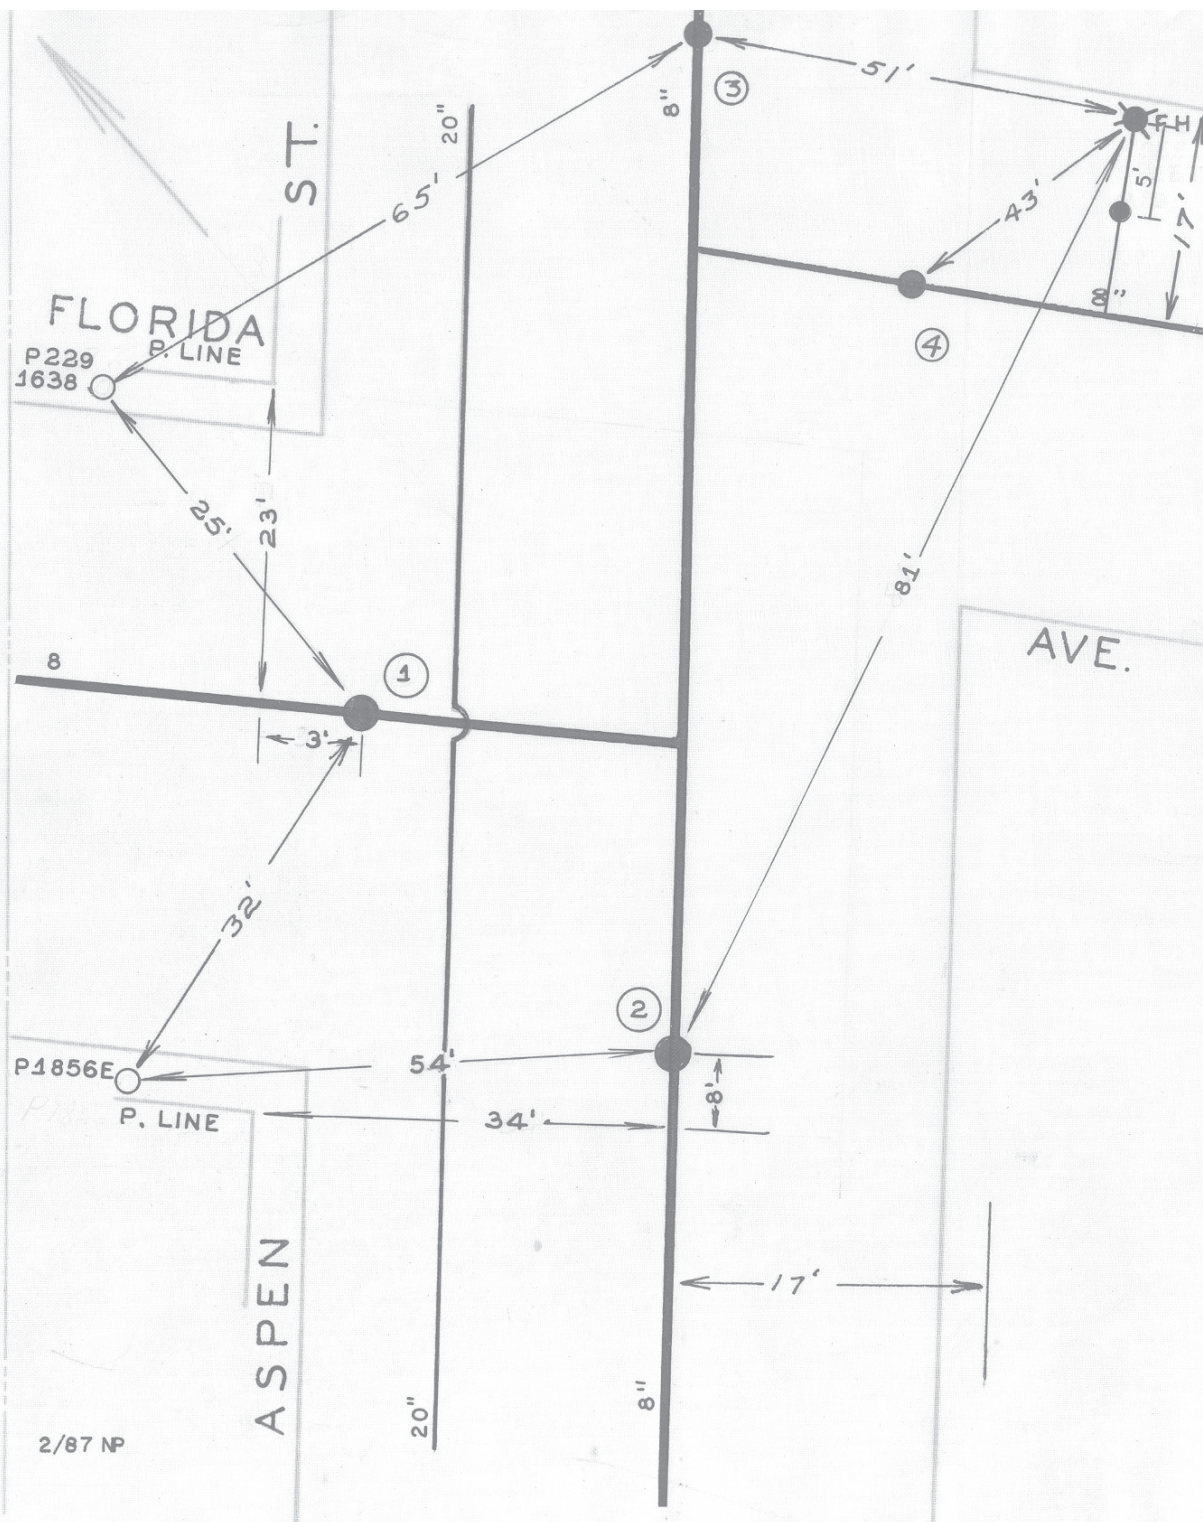


[illegible]

ASPEN STREET &
FLORIDA AVENUE

SEC. MAP 246

N.W.

PAGE NO. NW266