


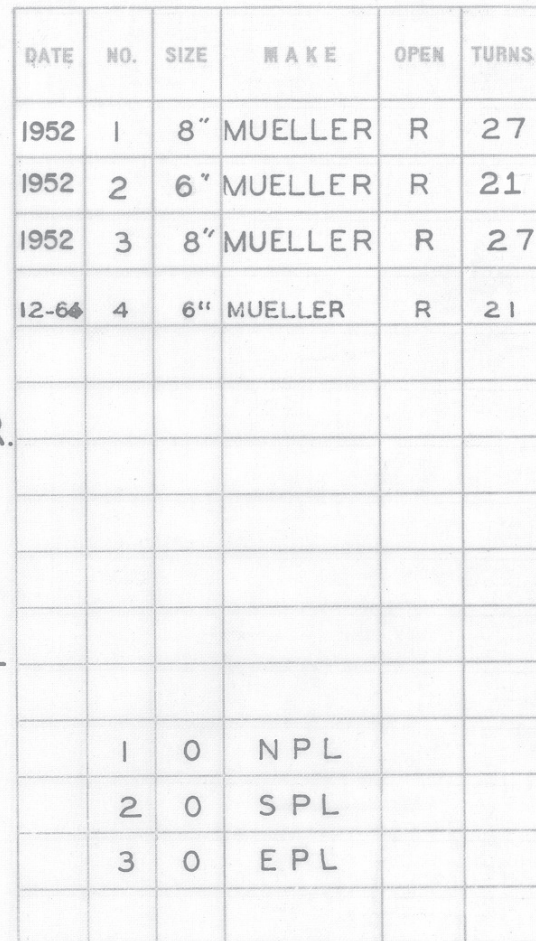

CITY OF ROANOKE—WATER DEPT.
VALVE DIAGRAM

ASPEN ST. & KIRKLAND
DRIVE N. W.

SEC. MAP 247

DATE PAGE NO.