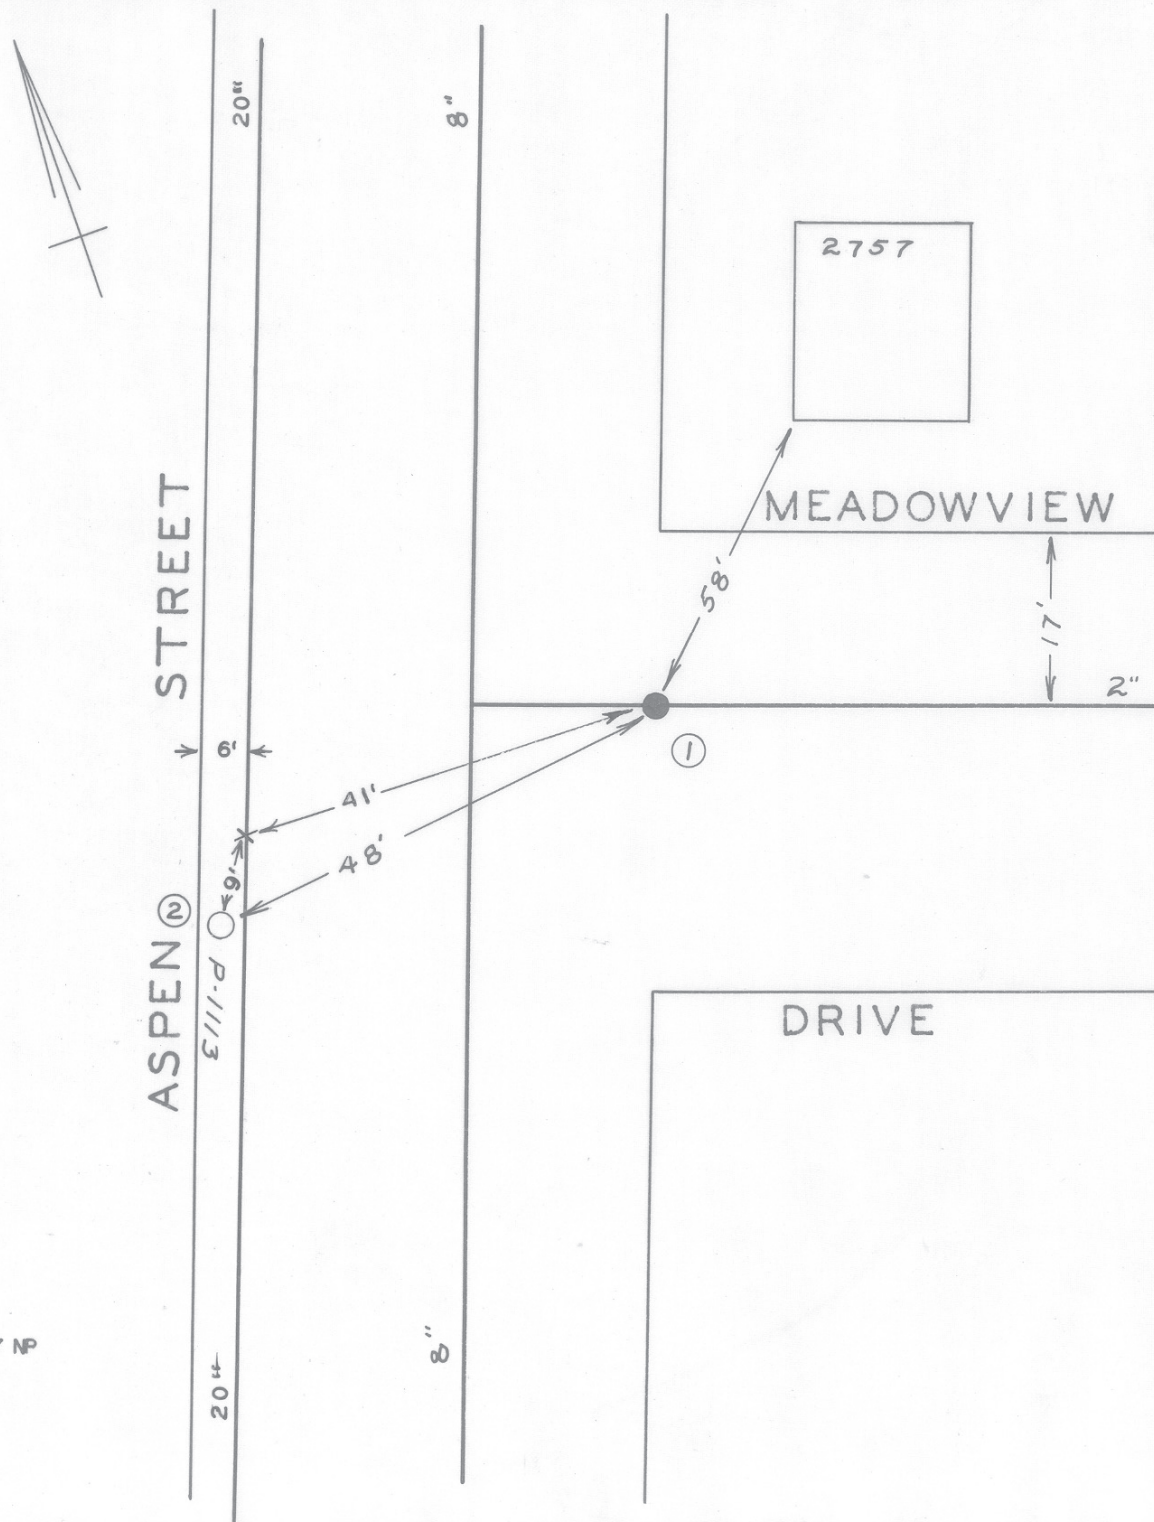


2/87 NP

[illegible]

CITY OF ROANOKE—WATER DEPT.
VALVE DIAGRAM

ASPEN STREET &
MEADOWVIEW DRIVE N.W.

SEC. MAP 247

DATE _____

PAGE NO.