


2508
Availon Ave

AVALON AVE. N. W.

P-230-562

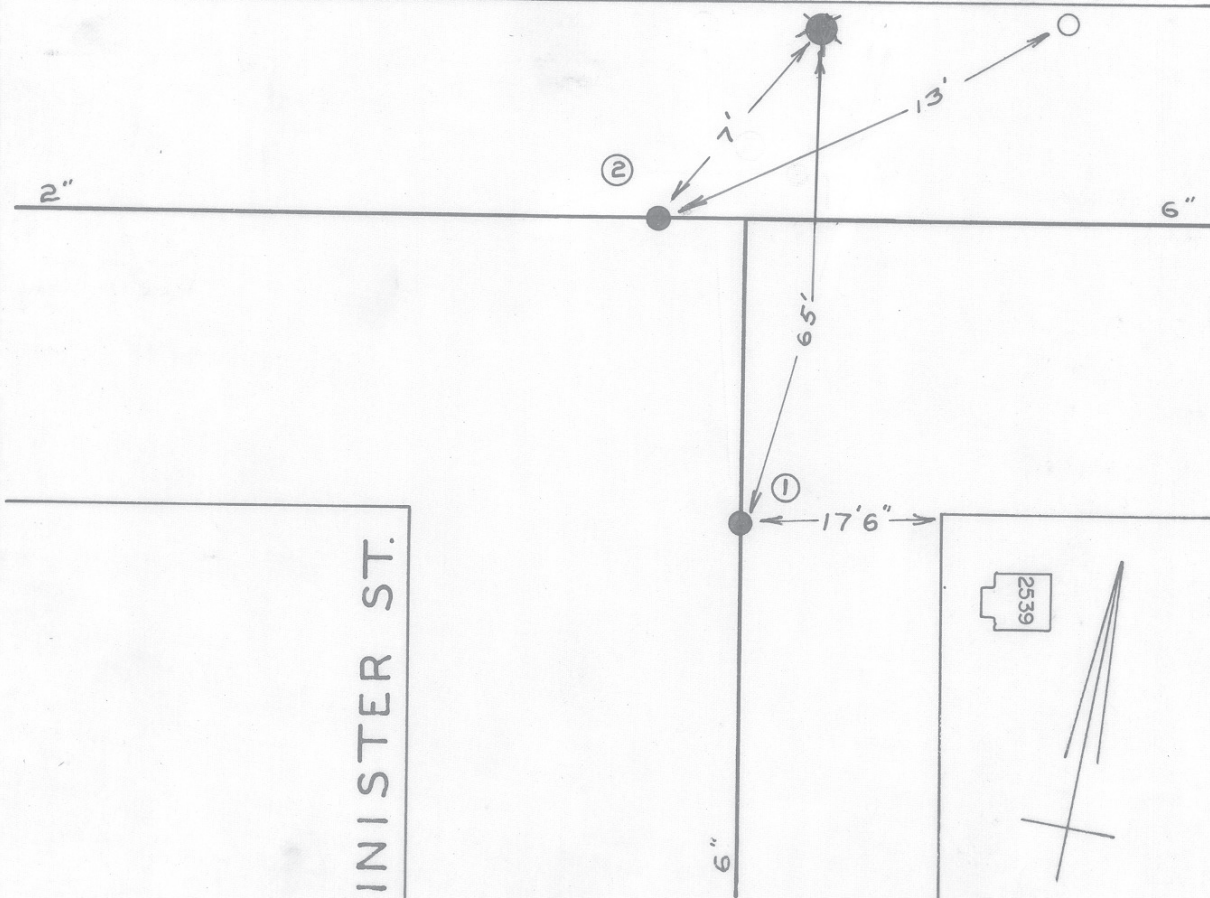

NORTHMINISTER ST.

2/87 NP

"IMPERIAL" TRACING CLOTH.
K & E CO., N. Y.

[illegible]

CITY OF ROANOKE—WATER DEPT.
VALVE DIAGRAM

AVALON AVE. & NORTH-
MINISTER ST. N. W.

SEC. MAP 226

DATE _____

PAGE NO.