


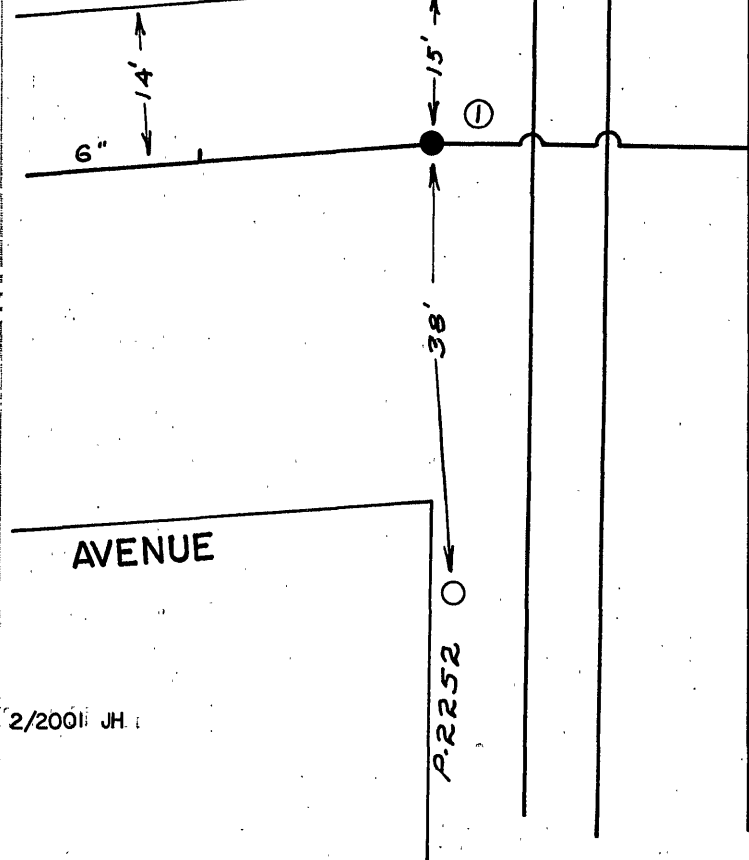

BARKLEY AVE..

CITY OF ROANOKE — WATER DEPT.
VALVE DIAGRAM

BARKLEY AVENUE 8
RAVENWOOD AVENUE 8
WILLIAMSON ROAD

SEC. MAP 216, 210 N.W.

DATE PAGE NO.